

Wayne
L 22
6-69

MISSISSIPPI
BOARD OF WATER COMMISSIONERS
416 North State Street
Jackson, Mississippi 39201

CODED

WATER WELL DRILLERS LOG

6-22 1969 Key West water well Wayne
date well completed firm name county well located

LANDOWNER: <u>Byron Woodson</u>	description of formations encountered	from	to
<u>Rt 4</u>			
<u>Laurel Miss</u> (mailing address)	<u>Clay</u>	<u>0</u>	<u>10</u>
	<u>Subsided clay</u>	<u>10</u>	<u>30</u>
	<u>Blue clay</u>	<u>30</u>	<u>80</u>
	<u>Sand</u>	<u>80</u>	<u>108</u>

WELL LOCATION:
sec. 17 T. 8 N R. 9 E
16 miles E of Laurel
(distance) (direction) (nearest town)

WELL PURPOSE: home
(home, irrigation, municipal, industrial)


- WELL COMPLETION DATA:
- (1) diameter (inches) 2 in
 - (2) total depth (feet) 108
 - (3) static water level (feet) 30 below above top of ground.
 - (4) casing plastic, 105
(material) (depth)
 - (size) If telescope see back.
 - (5) screen 5, 105
(length) (depth to top)
 - 1/4, st steel
(size) (material)
 - (6) pump 1/2, 5
(HP) (yield gpm)
 - REA
(type power)
 - (7) electric log no
(yes or no)
 - (organization running log)
 - (8) how well bottom plugged wash water

DRILLERS REMARKS:

MISS. Bd. of
WATER

If well telescopes please sketch and show depths.

GROUND LEVEL

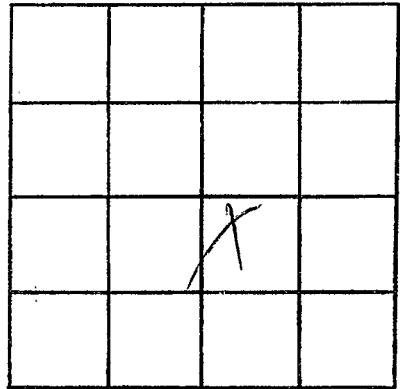

SECTION 8

Please indicate well location X.

ADDITIONAL INFORMATION

If more than one screen, show locations of each on sketch.