

CODED

WAYNE
L24
10-29-69

MISSISSIPPI
BOARD OF WATER COMMISSIONERS
416 North State Street
Jackson, Mississippi 39201

WATER WELL DRILLERS LOG

10-29 1969 Ray West Wayne
date well completed firm name county well located

LANDOWNER: George Pugh
Rt 1
Waynesboro
(mailing address)

WELL LOCATION:
sec 35 T 8 N R 9 E
2.0 miles S.E. of Leland
(distance) (direction) (nearest town)

WELL PURPOSE: home
(home, irrigation, municipal, industrial)


WELL COMPLETION DATA:
(1) diameter (inches) 2 in
(2) total depth (feet) 117
(3) static water level (feet) 15 below above top of ground.
(4) casing galv 113
(material) (depth)
(size) if telescope see back.
(5) screen 5 113
(length) (depth to top)
1 1/2 steel
(size) (material)
(6) pump 1/2 6
(HP) (yield gpm)
R&A
(type power)
(7) electric log NO
(yes or no)
(organization running log)
(8) how well bottom plugged unproductive

description of formations encountered	from	to
	<u>clay</u>	<u>0</u>
<u>hard clay</u>	<u>14</u>	<u>28</u>
<u>clay</u>	<u>28</u>	<u>50</u>
<u>soft clay</u>	<u>50</u>	<u>80</u>
<u>sand</u>	<u>80</u>	<u>83</u>
<u>clay</u>	<u>83</u>	<u>103</u>
<u>sand</u>	<u>103</u>	<u>117</u>

DRILLERS REMARKS:

If well telescopes please sketch and show depths.

GROUND LEVEL

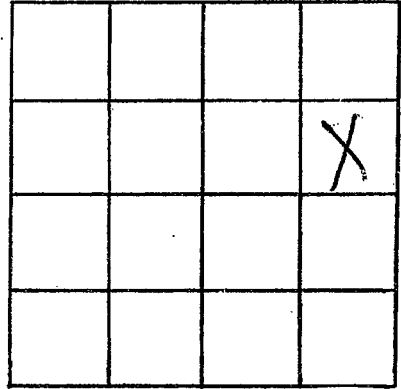

SECTION

35

Please indicate well location X.

ADDITIONAL INFORMATION

If more than one screen,
show locations of each on sketch.

NOV 20 1951

WATER CONTROL BOARD
WASHINGTON, D.C.