

CODED

MISSISSIPPI  
BOARD OF WATER COMMISSIONERS  
416 North State Street  
Jackson, Mississippi 39201

Wayne  
L25  
11-24-69

WATER WELL DRILLERS LOG

11-24 1969 Ray V West Wayne  
date well completed firm name county well located

LANDOWNER: Singleton  
Rt # Laurel Miss  
~~Wagonboro~~  
(mailing address)

description of formations encountered	from	to
	<u>Clay</u>	<u>0</u>
<u>Sandy Clay</u>	<u>9</u>	<u>32</u>
<u>Clay</u>	<u>32</u>	<u>75</u>
<u>sand</u>	<u>75</u>	<u>136</u>

WELL LOCATION:  
sec. 16 T. 8 N. R. 9 E  
S W  
14 miles E of Laurel  
(distance) (direction) (nearest town)

WELL PURPOSE: home  
(home, irrigation, municipal, industrial)

- WELL COMPLETION DATA:
- (1) diameter (inches) 2
  - (2) total depth (feet) 136
  - (3) static water level (feet) 32 below / above top of ground.
  - (4) casing galv (material), (depth)  
(size) if telescope see back.
  - (5) screen 5 (length), 131 (depth to top)  
1 1/4 (size), st steel (material)
  - (6) pump 1/2 (HP), 8 (yield gpm)  
R.E.A (type power)
  - (7) electric log no (yes or no)

(organization running log)  
(8) how well bottom plugged washed


DRILLERS REMARKS:

DEC 31 1969

MISS. BD. OF  
WATER COMMISSIONERS

If well telescopes please sketch and show depths.

GROUND LEVEL

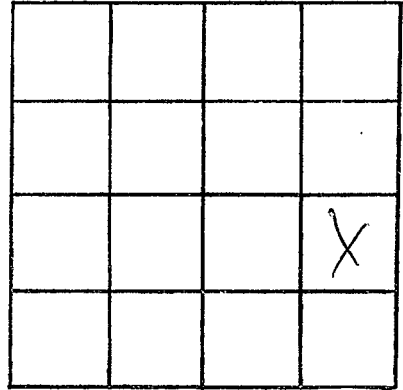

SECTION 16

Please indicate well location X.

ADDITIONAL INFORMATION

If more than one screen,  
show locations of each on sketch.