

Wayne  
L 27  
1-9-70

MISSISSIPPI  
BOARD OF WATER COMMISSIONERS  
416 North State Street  
Jackson, Mississippi 39201

CODED  
CODED

WATER WELL DRILLERS LOG

1-9 1970 Reynolds Water Well Wayne  
date well completed firm name county well located

LANDOWNER	description of formations encountered	from	to
Jerry Ford	Clay	0	10
Rt 1	Blue clay	10	115
Waynesboro Miss	sands	115	132
(mailing address)			

WELL LOCATION:  
sec. 15 T 8 N R 9 E  
14 miles East Laurel  
(distance) (direction) (nearest town)

WELL PURPOSE: ~~Home~~ ~~Drain~~ ~~Drain~~  
(home, irrigation, municipal, industrial)

- WELL COMPLETION DATA:
- (1) diameter (inches) 2
  - (2) total depth (feet) 132
  - (3) static water level (feet) 2 below top of ground.
  - (4) casing galv 127  
(material) (depth)
  - (size) if telescope see back.
  - (5) screen 6 127  
(length) (depth to top)
  - 1 1/2 st steel  
(size) (material)
  - (6) pump none 5  
(HP) (yield gpm)
  - Rea  
(type power)
  - (7) electric log no  
(yes or no)

(organization running log)  
(8) how well bottom plugged washed


DRILLERS REMARKS:

JAN 26 1970

MISS. BD. OF  
WATER COMM.

If well telescopes please sketch and show depths.

GROUND LEVEL

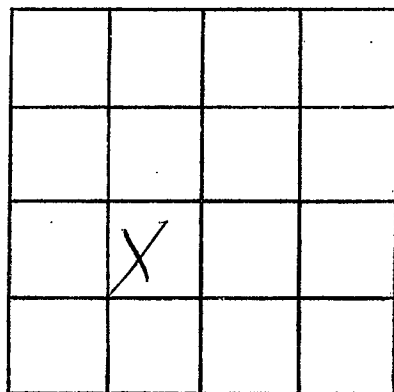

SECTION 15

Please indicate well location X.

ADDITIONAL INFORMATION

If more than one screen, show locations of each on sketch.