

Wayne
L 28
3-9-70

MISSISSIPPI
BOARD OF WATER COMMISSIONERS
416 North State Street
Jackson, Mississippi 39201

WATER WELL DRILLERS LOG

Mar 9 1970 Roy West Water Well Drilling Co. Inc.
date well completed firm name county well located

COPIED

LANDOWNER: A. O. Blue
Rt 1
Laurel Miss
(mailing address)

description of formations encountered	from	to
clay	0	8
sandy clay	8	19
sand	19	35
sandy clay	35	140
hard clay	140	158
sand	158	173

WELL LOCATION:
sec. 8 T 8 N R 9 E
S W

miles of (distance) (direction) (nearest town)

WELL PURPOSE: Home
(home, irrigation, municipal, industrial)

- WELL COMPLETION DATA:
- (1) diameter (inches) 2
 - (2) total depth (feet) 173
 - (3) static water level (feet) 47 below above top of ground.
 - (4) casing galv 168 (material) (depth)
 - (size) if telescope see back.
 - (5) screen 5ft 168 (length) (depth to top)
 - 1/4" st steel (size) (material)
 - (6) pump 1 7 (HP) (yield gpm)
 - Rea (type power)
 - (7) electric log NO (yes or no)

COPIED

(organization running log)

(8) how well bottom plugged wash water


APR - 7 1970

DRILLERS REMARKS:

MISS. BD. OF
WATER COMM.

If well telescopes please sketch and show depths.

GROUND LEVEL

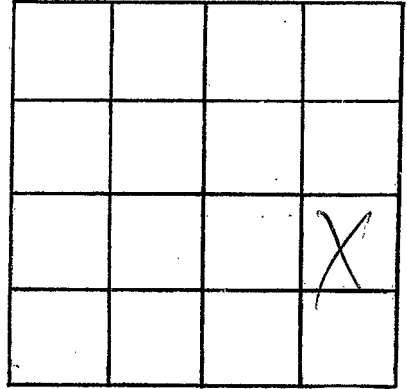

SECTION 8

Please indicate well location X.

ADDITIONAL INFORMATION

If more than one screen,
show locations of each on sketch.