

MISSISSIPPI
BOARD OF WATER COMMISSIONERS
416 North State Street
Jackson, Mississippi 39201

CODED

WATER WELL DRILLERS LOG

WAYNE
L29
8-3-70

Aug 3 1970 Port Drilling & Log Wayne
date well completed firm name county well located

LANDOWNER: House Mr. Lemon
2112 Commercial Miss
(mailing address)

description of formations encountered	from	to
rest chalk	0	7
fine sand	9	25
blue sand & chalk	25	34
blue chalk		34
blue chalk	34	48
sandy chalk	48	55
chalk	55	68
sand & chalk	68	87
chalk	87	121
fine clean sand	121	128
chalk & sand	128	134
fine in clean sand	134	140
rest on chalk		

WELL LOCATION:
sec. 17 T 20 N R 7 E
S (W)
15 miles west of Waynesboro
(distance) (direction) (nearest town)

WELL PURPOSE: drinking
(home, irrigation, municipal, industrial)

- WELL COMPLETION DATA:
- (1) diameter (inches) 2"
 - (2) total depth (feet) 140'
 - (3) static water level (feet) 48' below top of ground.
 - (4) casing steel 126'
(material) (depth)
2" if telescope see back.
(size)
 - (5) screen 6" 134'
(length) (depth to top)
1 1/4" 90 ga. S.S.
(size) (material)
 - (6) pump 1/2 6
(HP) (yield gpm)
elec
(type power)
 - (7) electric log no
(yes or no)
 - (organization running log)
 - (8) how well bottom plugged fine sand

6' 1 1/4" 80 ga S.S. with
1" 1" N
8' 2" 1 1/4" pipe joint
in with packer
55' 1 1/4" drop pipe

CODED


SEP 9 1970

DRILLERS REMARKS:

MISS. BD. OF
WATER COMM.

If well telescopes please sketch and show depths.

GROUND LEVEL

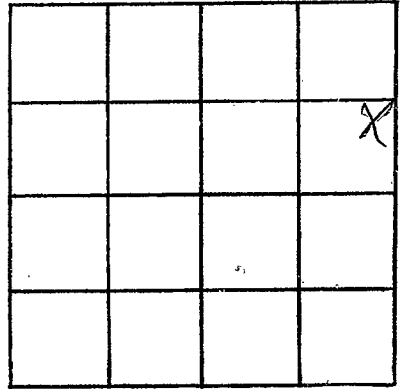

SECTION 17

Please indicate well location X.

ADDITIONAL INFORMATION

If more than one screen,
show locations of each on sketch.