

MISSISSIPPI
BOARD OF WATER COMMISSIONERS
416 North State Street
Jackson, Mississippi 39201

CODED

WATER WELL DRILLERS LOG

WAYNE
L 30
9-2-70

Sept 2 1970 Robert D. Williams, Inc. Wayne
date well completed firm name county well located

LANDOWNER: Way Harty
640 S. Magnolia
Laurel, Miss.
(mailing address)

description of formations encountered	from	to
unconsolidated ch. alk.	0	35
blk. ch. alk. sandstone	35	90
small sand	90	100
Chalk	100	150
sand	150	155
Chalk	155	160
consolidated fine	160	180
sandstone / coarse	180	195
ss - 17 ch. alk.	195	205

WELL LOCATION:
sec 28 T 8 N R 9 E
S W
15 miles west of Waynesboro
(distance) (direction) (nearest town)

WELL PURPOSE: Drinking Water
(home, irrigation, municipal, industrial)

WELL COMPLETION DATA:
(1) diameter (inches) 4"
(2) total depth (feet) 195'
(3) static water level (feet) 1' below top of ground.
(4) casing steel 168'
(material) (depth)
4" if telescope see back.
(size)
(5) screen 13' 131'
(length) (depth to top)
10' 3" OD 1/2" 13' 3/4" OD S.S.
(size) (material)
(6) pump 400
(HP) (yield gpm)
Air Compressor on top
(type power)
(7) electric log yes
(yes or no)
(organization running log)
(8) how well bottom plugged 2' sandstone gravel

10' 3/4" OD 8' scht S.S.
on top 3' 2 1/2" OD 8' scht
S.S. on bottom with
2" backwash valve
14' 2 1/2" lag pipe
set in with rubber
packer

CODED


SEP 8 1970

DRILLERS REMARKS:

MISS. BD. OF
WATER COMM.

If well telescopes please sketch and show depths.

GROUND LEVEL

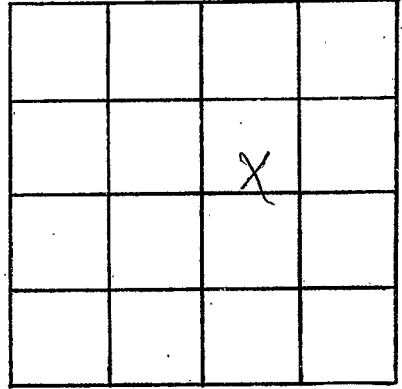

SECTION 28

Please indicate well location X.

ADDITIONAL INFORMATION

If more than one screen,
show locations of each on sketch.