

WAYNE  
L31  
8-5-70

MISSISSIPPI  
BOARD OF WATER COMMISSIONERS  
416 North State Street  
Jackson, Mississippi 39201

**CODED**

WATER WELL DRILLERS LOG

Aug 5 1970 Roy V. Westwater Wayne  
date well completed firm name county well located

LANDOWNER: Junior West  
Rt 1  
Laud Miss  
(mailing address)

description of formations encountered	from	to
sandy clay	0	8
clay	8	84
fine sand	84	95
clay	95	115
sandy clay	115	130
clay	130	190
sand	190	205

WELL LOCATION:  
sec 28 T 8 S R 9 E  
20 miles S.E. of Laud  
(distance) (direction) (nearest town)

WELL PURPOSE: home  
(home, irrigation, municipal, industrial)

- WELL COMPLETION DATA:
- (1) diameter (inches) 2
  - (2) total depth (feet) 205
  - (3) static water level (feet) 40 below top of ground.
  - (4) casing Galv 200 (material) (depth)
  - (size) if telescope see back.
  - (5) screen 5 200 (length) (depth to top)
  - 1 1/4 St Steel (size) (material)
  - (6) pump 3/4 9 (HP) (yield gpm)
  - Rea (type power)
  - (7) electric log No (yes or no)
  - (organization running log)
  - (8) how well bottom plugged Washuolie


**CODED**

DRILLERS REMARKS:

AUG 25 1970

If well telescopes please sketch and show depths.

GROUND LEVEL

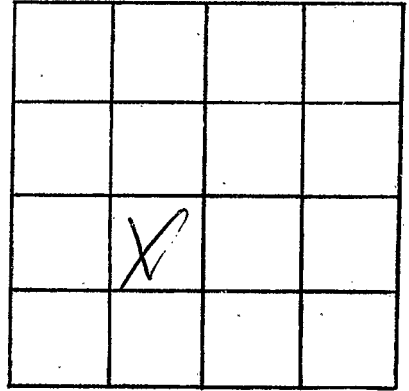

SECTION 28

Please indicate well location X.

ADDITIONAL INFORMATION

If more than one screen,  
show locations of each on sketch.