

Wayne  
L 33  
10-25-71

MISSISSIPPI  
BOARD OF WATER COMMISSIONERS  
416 North State Street  
Jackson, Mississippi 39201

DEC 9 1971  
**CODED**

WATER WELL DRILLERS LOG

Oct 25 1971 Roy V. Aust Waterwells Wayne  
date well completed firm name county well located

LANDOWNER: George Cooley  
Rt 1  
Laurel Miss  
(mailing address)

description of formations encountered	from	to
Clay	0	10
Sand	10	30
Clay	30	40
Sand	40	69

WELL LOCATION:  
sec. 3 T. 8 N. R. 9 E  
14 miles S of Laurel  
(distance) (direction) (nearest town)

WELL PURPOSE: home  
(home, irrigation, municipal, industrial)


- WELL COMPLETION DATA:
- (1) diameter (inches) 2 in
  - (2) total depth (feet) 69
  - (3) static water level (feet) 30 below top of ground.
  - (4) casing plastic 64 (material) (depth)
  - (size) If telescope see back.
  - (5) screen 5 64 (length) (depth to top)
  - 1 1/2 St. steel (size) (material)
  - (6) pump 1/2 8 (HP) (yield gpm)
  - Rea (type power)
  - (7) electric log no (yes or no)
  - (organization running log)
  - (8) how well bottom plugged Wash water

**CODED**

DRILLERS REMARKS:

If well telescopes please sketch and show depths.

GROUND LEVEL

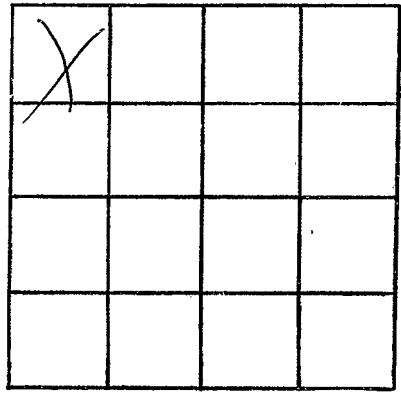

SECTION 3

Please indicate well location X.

ADDITIONAL INFORMATION

A series of horizontal lines for writing additional information.

If more than one screen, show locations of each on sketch.