

Wayne  
L 34  
11-30-71

MISSISSIPPI  
BOARD OF WATER COMMISSIONERS  
416 North State Street  
Jackson, Mississippi 39201

WATER WELL DRILLERS LOG

**CODED**

Nov 30 1971 Roy Westwater wells Wayne  
date well completed firm name county well located

LANDOWNER: Leon West  
Waynesboro  
Rt 1  
(mailing address)

description of formations encountered	from	to
Sandy clay	0	15
clay	15	60
sand	60	85
clay	85	135
sand	135	170
Blue clay	170	240
sand	240	250

WELL LOCATION:  
sec. 31 T 9 N R 8 E  
S W  
15 miles E of Laurel  
(distance) (direction) (nearest town)

WELL PURPOSE: home  
(home, irrigation, municipal, industrial)


- WELL COMPLETION DATA:
- (1) diameter (inches) 2 in
  - (2) total depth (feet) 250
  - (3) static water level (feet) 20 below top of ground.
  - (4) casing galv (material) (depth) (size) if telescope see back.
  - (5) screen 10 ft 240 (length) (depth to top)  
1 1/2 Stainless steel (size) (material)
  - (6) pump 1 hp 8 (HP) (yield gpm)  
Rea (type power)
  - (7) electric log No (yes or no)
  - (organization running log) Wash water
  - (8) how well bottom plugged

**CODED**

DRILLERS REMARKS:

If well telescopes please sketch and show depths.

GROUND LEVEL

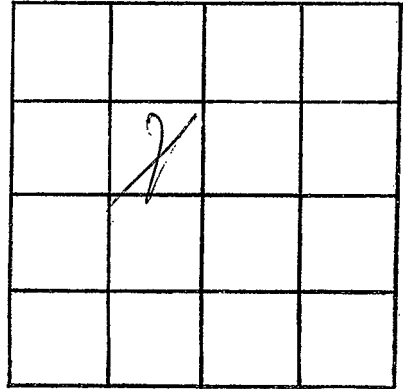

SECTION 31

Please indicate well location X.

ADDITIONAL INFORMATION

If more than one screen,  
show locations of each on sketch.