

Wayne
L35
12-3-71

MISSISSIPPI
BOARD OF WATER COMMISSIONERS
416 North State Street
Jackson, Mississippi 39201

CODED

MISS. BD. OF
WATER COMM

WATER WELL DRILLERS LOG

Dec 3 1971 date well completed
71 Roy West Waterwells Wayne firm name
county well located

LANDOWNER:	description of formations encountered	from	to
Larry Ford	Clay	0	16
Rt 4	Sandy clay	16	28
Laural miss	Clay	28	90
(mailing address)	fine sand	90	110
	Clay	110	125
	Sand	125	150

WELL LOCATION:
sec. 15 T 8 N R 9 E
S 8
15 miles 8 of Laural miss
(distance) (direction) (nearest town)

WELL PURPOSE: Home
(home, irrigation, municipal, industrial)


- WELL COMPLETION DATA:
- (1) diameter (inches) 2 in
 - (2) total depth (feet) 150
 - (3) static water level (feet) 16 below top of ground.
 - (4) casing plastic 145 (material) (depth)
 - (size) If telescope see back.
 - (5) screen 8 ft 145 (length) (depth to top)
 - 1 1/2 Stainless steel (size) (material)
 - (6) pump 3/4 10 (HP) (yield gpm)
 - Rea (type power)
 - (7) electric log No (yes or no)
 - (organization running log)
 - (8) how well bottom plugged washed

CODED

DRILLERS REMARKS:

If well telescopes please sketch and show depths.

GROUND LEVEL

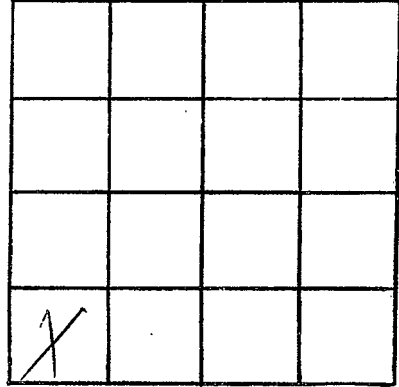

SECTION 15

Please indicate well location X.

ADDITIONAL INFORMATION

If more than one screen,
show locations of each on sketch.