

T M C A

MISSISSIPPI BOARD OF WATER COMMISSIONERS
416 North State Street
Jackson, Mississippi 39201

MAR 17 1972

WATER WELL DRILLERS LOG

CODED

Wayne
L 36
2-15-72

Feb 15 1972 Roy H West Water Wells Wayne
date well completed firm name county well located

LANDOWNER: Mrs. Johnny
Hendry Rt 1
Waynesboro
(mailing address)

description of formations encountered	from	to
Dowdy Clay	0	25
Clay	25	50
Dowdy Clay	50	85
Sand	85	116

WELL LOCATION:
sec. 15 T 8 N R 9 E
S S W
14 miles E of Laurel
(distance) (direction) (nearest town)

WELL PURPOSE: home
(home, irrigation, municipal, industrial)


- WELL COMPLETION DATA:
- (1) diameter (inches) 2
 - (2) total depth (feet) 116 ft
 - (3) static water level (feet) 45 below top of ground.
 - (4) casing Plastic 110 (material) (depth)
 - (size) if telescope see back.
 - (5) screen 5 110 (length) (depth to top)
 - (size) (material)
 - (6) pump 34 8 (HP) (yield gpm)
 - (type power) Rea
 - (7) electric log no (yes or no)
 - (organization running log)
 - (8) how well bottom plugged Washed

CODED

DRILLERS REMARKS:

If well telescopes please sketch and show depths.

GROUND LEVEL

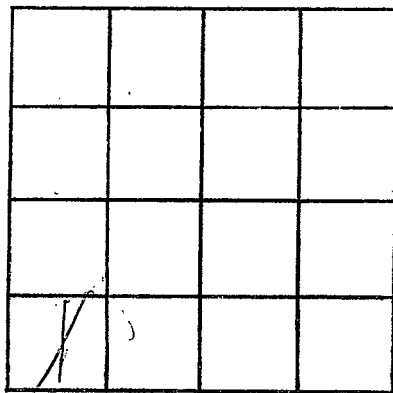

SECTION 15

Please indicate well location X.

ADDITIONAL INFORMATION

If more than one screen,
show locations of each on sketch.