

WAYNE  
L 38  
4-17-72

MISSISSIPPI  
BOARD OF WATER COMMISSIONERS  
416 North State Street  
Jackson, Mississippi 39201

**CODED**

WATER WELL DRILLERS LOG

1972 April 17 date well completed      Robert Drilling & Supply firm name      Wayne county well located

LANDOWNER: Phil Lips  
Moseley  
At 1 Waynesboro Miss  
(mailing address)

description of formations encountered	from	to
<u>clay</u>	<u>0</u>	<u>15</u>
<u>fine sand</u>	<u>15</u>	<u>27</u>
<u>stagnant on chalk</u>		

WELL LOCATION:  
sec 26 T 8 N R 9 E  
9 miles west of Waynesboro  
(distance) (direction) (nearest town)

WELL PURPOSE: home  
(home, irrigation, municipal, industrial)

- WELL COMPLETION DATA:
- (1) diameter (inches) 1 1/4"
  - (2) total depth (feet) 27'
  - (3) static water level (feet) 16' (below) top of ground.
  - (4) casing steel 21'  
(material) (depth)  
1 1/4" if telescope see back.  
(size)
  - (5) screen 6' 21'  
(length) (depth to top)  
1 1/4" 80 gpm S.S.  
(size) (material)
  - (6) pump 1/3 3  
(HP) (yield gpm)  
elec.  
(type power)
  - (7) electric log no  
(yes or no)
- (organization running log)

(8) how well bottom plugged  
flush point

DRILLERS REMARKS:


**CODED**

MAY 12 1972

MISS. RD. OF  
WATER COMMISSIONERS

If well telescopes please sketch and show depths.

GROUND LEVEL

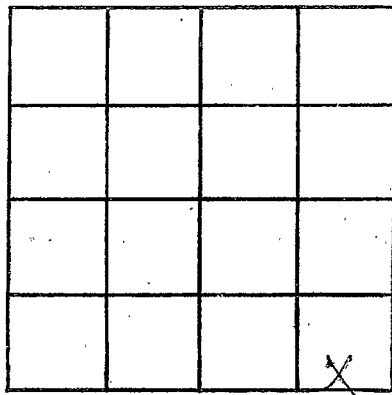

SECTION 26

Please indicate well location X.

ADDITIONAL INFORMATION

If more than one screen, show locations of each on sketch.