

WAYNE  
L 39  
4-26-72

MISSISSIPPI  
BOARD OF WATER COMMISSIONERS  
416 North State Street  
Jackson, Mississippi 39201

WATER WELL DRILLER

**CODED**

April 26 1972 Roy U West Water Well Wayne  
date well completed firm name county well located

LANDOWNER: Grady Cooley  
Rt 1  
Waynesboro  
(mailing address)

description of formations encountered

from to

clay	0	6
sand	6	24
clay	24	36
solidly clay	36	48
clay	48	60
sand	60	85

WELL LOCATION:

sec. 35 T. 8 N. R. 9 E.  
2.5 miles S-E of Town  
(distance) (direction) (nearest town)

WELL PURPOSE: Chicken House  
(home, irrigation, municipal, industrial)

WELL COMPLETION DATA:

- (1) diameter (inches) 2 in
- (2) total depth (feet) 85
- (3) static water level (feet) 15 below above top of ground.
- (4) casing galv 80  
(material) (depth)
- (size) If telescope see back.
- (5) screen 5 ft 80  
(length) (depth to top)  
1/4 St Steel  
(size) (material)
- (6) pump 1 10  
(HP) (yield gpm)  
R&A  
(type power)
- (7) electric log NO  
(yes or no)

**CODED**

(organization running log)


(8) how well bottom plugged closed

APR 26 1972

DRILLERS REMARKS:

If well telescopes please sketch and show depths.

GROUND LEVEL

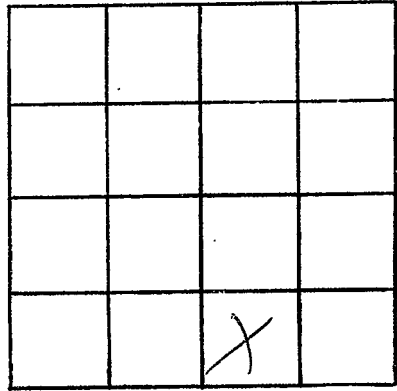

SECTION 35

Please indicate well location X.

ADDITIONAL INFORMATION

If more than one screen,  
show locations of each on sketch.