

MISSISSIPPI
BOARD OF WATER COMMISSIONERS
416 North State Street
Jackson, Mississippi 39201

CODED

WATER WELL DRILLERS LOG

WAYNE

Wayne
L40
5-16-72

6 May 1972 date well completed
72 Ray Urist water wells firm name
WAYNE county well located

LANDOWNER:	description of formations encountered	from	to
Brace Overstreet	Clay	0	8
RT 4	Sandy Clay	8	125
Laurel Miss (mailing address)	ROCK	125	147
WELL LOCATION:			
sec. 16 T. 8 ^N R. 9 E			
2.8 miles S ^W of Stennis			
WELL PURPOSE: home (home, irrigation, municipal, industrial)			
WELL COMPLETION DATA:			
(1) diameter (inches) 2			
(2) total depth (feet) 147			
(3) static water level (feet) 30 below top of ground.			
(4) casing: plastic 142 (material) (depth)			
(size) if telescope see back.			
(5) screen 5 142 (length) (depth to top)			
1.4 St Steel (size) (material)			
(6) pump 1 9 (HP) (yield gpm)			
PEA (type power)			
(7) electric log 70 (yes or no)			
(organization running log)			
(8) how well bottom plugged Washwater			
DRILLERS REMARKS:			


CODED

JUN 16 1972

MISS. BD. U.
STATE COLLEGE

If well telescopes please sketch and show depths.

GROUND LEVEL

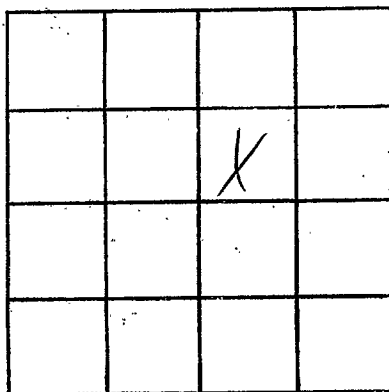

SECTION 16

Please indicate well location X.

ADDITIONAL INFORMATION

If more than one screen, show locations of each on sketch.