

MISSISSIPPI
BOARD OF WATER COMMISSIONERS
416 North State Street
Jackson, Mississippi 39201

CODED

WATER WELL DRILLERS LOG

Wayne
L 41
9-5-72

Sept 5 1972 Roy V. Vint Water Wells Wayne
date well completed firm name county well located

LANDOWNER: James B. Green
RT 1 Box 102 Waynesboro
(mailing address)

description of formations encountered	from	to
clay	0	5
sandy clay	5	15
clay	15	85
lime sand	85	90
sand	90	110

WELL LOCATION:
sec. 35 T. 8 N. R. 7 E.
20 miles S.E. of Laurel
(distance) (direction) (nearest town)

WELL PURPOSE: home
(home, irrigation, municipal, industrial)

- WELL COMPLETION DATA:
- (1) diameter (inches) 2
 - (2) total depth (feet) 110
 - (3) static water level (feet) 20 below top of ground.
 - (4) casing plastic, 100 (material) (depth)
 - (size) if telescope see back.
 - (5) screen 10, 100 (length) (depth to top)
 - 2, plastic (size) (material)
 - (6) pump 1/2, 5 (HP) (yield gpm)
 - Rea (type power)
 - (7) electric log 70 (yes or no)
 - (organization running log)
 - (8) how well bottom plugged washed

CODED


OCT 12 1972

DRILLERS REMARKS:

MISS. B.O. WATER COMMISSIONERS

If well telescopes please sketch and show depths.

GROUND LEVEL

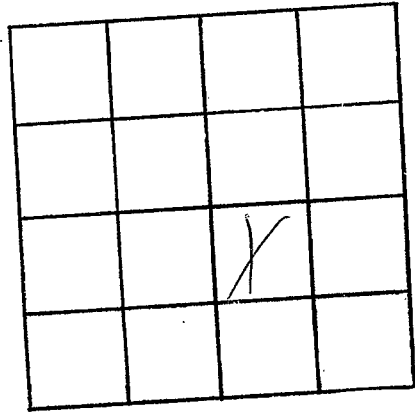

SECTION 35

Please indicate well location X.

ADDITIONAL INFORMATION

If more than one screen, show locations of each on sketch.