

**MISSISSIPPI  
BOARD OF WATER COMMISSIONERS**  
416 North State Street  
Jackson, Mississippi 39201

**WATER WELL DRILLERS LOG**

Wayne  
L 42  
10-6-72

Oct 6 1972 Roy West Waterwells Wayne  
date well completed firm name county well located

LANDOWNER: Joe R. Lacour  
Rt 4  
Laurel Miss  
(mailing address)

description of formations encountered	from	to
<u>Clay</u>	<u>0</u>	<u>6</u>
<u>Sandy Clay</u>	<u>6</u>	<u>25</u>
<u>Clay</u>	<u>25</u>	<u>70</u>
<u>Sandy Clay</u>	<u>70</u>	<u>120</u>
<u>Sand</u>	<u>120</u>	<u>140</u>

WELL LOCATION:  
sec. 31 T. 8 N. R. 9 E.  
18 miles S. 6 of Laurel  
(distance) (direction) (nearest town)

WELL PURPOSE: Home  
(home, irrigation, municipal, industrial)

- WELL COMPLETION DATA:
- (1) diameter (inches) 2
  - (2) total depth (feet) 140
  - (3) static water level (feet) 70 below / above top of ground.
  - (4) casing plastic, 135  
(material) (depth)
  - (size) if telescope see back.
  - (5) screen 5 ft, 135  
(length) (depth to top)
  - 1/4, st. steel  
(size) (material)
  - (6) pump 3/4 5  
(HP) (yield gpm)
  - R.E.A.  
(type power)
  - (7) electric log no  
(yes or no)
  - (organization running log)
  - (8) how well bottom plugged as usual


NOV 16 1972

DRILLERS REMARKS:

ED. US  
MISSISSIPPI

If well telescopes please sketch and show depths.

GROUND LEVEL

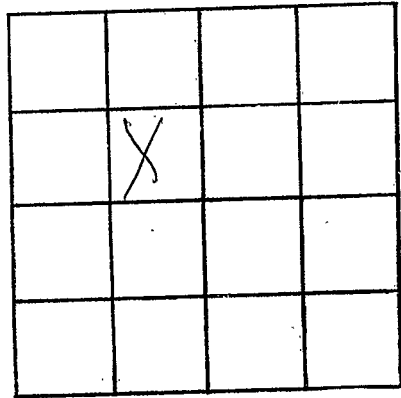

SECTION 31

Please indicate well location X.

ADDITIONAL INFORMATION

If more than one screen, show locations of each on sketch.