

WAYNE

L43

2-7-73

MISSISSIPPI BOARD OF WATER COMMISSIONERS
416 North State Street
Jackson, Mississippi 39201

CODED

WATER WELL DRILLERS LOG

2-7 1973 JR. GREEN WATERWELL WAYNE CO
date well completed firm name county well located

LANDOWNER:

MICHEL E. MCCRANEY

ROUTE 6 LAUREL MISS
(mailing address) 39440

WELL LOCATION:

sec. 19 T 8 N R 9 W

10 miles EAST of LAUREL
(distance) (direction) (nearest town)

WELL PURPOSE:

(home, irrigation, municipal, industrial)

WELL COMPLETION DATA:

- (1) diameter (inches) 4"
- (2) total depth (feet) 70'
- (3) static water level (feet) 42 below top of ground.
- (4) casing PVC, 60 (material) (depth)
(size) if telescope see back.
- (5) screen 10, 60 (length) (depth to top)
2, 008 PVC (size) (material)
- (6) pump 1/2, 6 (HP) (yield gpm)
(type power)
- (7) electric log NO (yes or no)
(organization running log)
- (8) how well bottom plugged

description of formations encountered

from to

YELLOW	0	5
FINE SAND	5	10
" "	10	14
PINK CHALK	14	20
" "	20	30
" "	30	40
FINE WHITESAND	40	50
" " "	50	60
" " "	60	70
WHITE CHALK	70	


CODED

MAR 2 1973

DRILLERS REMARKS:

If well telescopes please sketch and show depths.

GROUND LEVEL

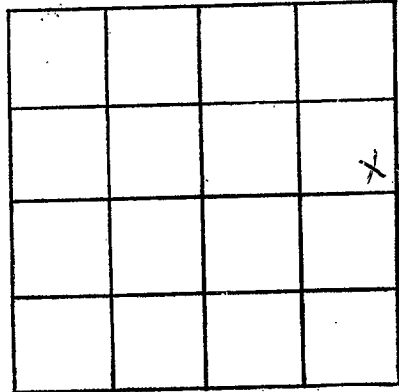

SE $\frac{1}{4}$ of NE $\frac{1}{4}$

SECTION 19

Please indicate well location X.

ADDITIONAL INFORMATION

If more than one screen, show locations of each on sketch.