

WAYNE
L 45
9-10-73

BOARD OF WATER COMMISSIONERS
416 North State Street
Jackson, Mississippi 39201

WATER WELL DRILLER

CODED

Sept 10 1973 date well completed
Ray West Water Wells Wayne firm name
Wayne county well located

LANDOWNER: Buck Oakley
Rt 1 Box 103
Waynesboro
(mailing address)

| description of formations encountered | from | to |
|---------------------------------------|------|-----|
| clay | 0 | 6 |
| sand | 6 | 30 |
| clay | 30 | 140 |
| sand | 140 | 175 |

WELL LOCATION:
sec 35 T 5 N R 9 E
20 miles S.E. of Laurel
(distance) (direction) (nearest town)

WELL PURPOSE: home
(home, irrigation, municipal, industrial)

WELL COMPLETION DATA:

- (1) diameter (inches) 2 in
- (2) total depth (feet) 175
- (3) static water level (feet) 3 below top of ground.
- (4) casing plastic, 170 (material) (depth)
- (size) if telescope see back.
- (5) screen 5, 170 (length) (depth to top)
- 1/4, St Steel (size) (material)
- (6) pump 1, 12 (HP) (yield gpm)
- R&A (type power)
- (7) electric log 70 (yes or no)
- (organization running log)
- (8) how well bottom plugged wash water


CODED

DRILLERS REMARKS:

SEP 19 1973

If well telescopes please sketch and show depths.

GROUND LEVEL

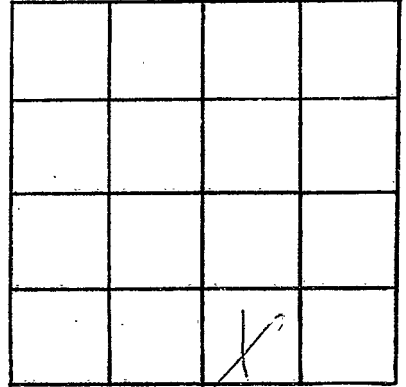

SECTION 35

Please indicate well location X.

ADDITIONAL INFORMATION

If more than one screen,
show locations of each on sketch.