

WAYNE

L 46

8-15-73

MISSISSIPPI BOARD OF WATER COMMISSIONERS  
416 North State Street  
Jackson, Mississippi 39201

CODED

SEP 12 1973

WATER WELL DRILLERS LOG

MISS. BD. OF WATER COMMISSIONERS

Aug 15 1973  
date well completed

Porter Drilling & Log  
firm name

21  
county well located

LANDOWNER: Herman Skova

description of formations encountered

from

to

At 1 Waynesboro Miss  
(mailing address)

0.00  
clay to sand  
hard sand  
sand + clay  
0 11  
11 19  
19 24  
24 26

WELL LOCATION:

sec 26 T 8 N R 9 E  
S W  
1 miles NE of Struthers  
(distance) (direction) (nearest town)

5' 1 1/2' 6' shot S.S. screen  
on end of cas

WELL PURPOSE: home  
(home, irrigation, municipal, industrial)

WELL COMPLETION DATA:

- (1) diameter (inches) 2'
- (2) total depth (feet) 26'
- (3) static water level (feet) 14' (below above top of ground)
- (4) casing steel, 21' (material) (depth)  
2' (size) if telescope see back.
- (5) screen 5' 21' (length) (depth to top)  
1 1/2" 6' shot S.S. (size) (material)
- (6) pump 3/4 2 1/2 (HP) (yield gpm)  
elec. (type power)
- (7) electric log no (yes or no)

CODED

19' 1 1/2' down pump  
11' 0"


(organization running log)

(8) how well bottom plugged  
steel plug

DRILLERS REMARKS:

If well telescopes please sketch and show depths.

GROUND LEVEL

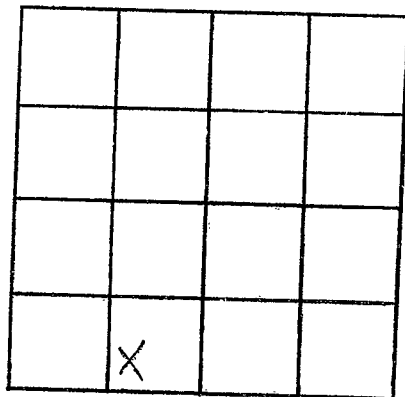

SECTION 26

Please indicate well location X.

ADDITIONAL INFORMATION

If more than one screen,  
show locations of each on sketch.