

WAYNE
L 47
8-6-73

MISSISSIPPI
BOARD OF WATER COMMISSIONERS
416 North State Street
Jackson, Mississippi 39201

CODED 12 1973

WATER WELL DRILLERS LOG

Aug 6 1973
date well completed

Boyer Drilling & Log
firm name

MISS. Bd. OF
WATER COMMISSIONERS
Wayne
county well located


LANDOWNER: <u>Mrs Laine Howard</u>	description of formations encountered	from	to
<u>All Magneshow Min</u> (mailing address)			
WELL LOCATION: sec <u>26</u> T <u>8</u> (N) R <u>9</u> (E) W <u>1</u> miles (distance) <u>NE</u> (direction) of <u>Howarth</u> (nearest town)	<u>rest clay + sand</u>	<u>0</u>	<u>12</u>
	<u>chalk</u>	<u>12</u>	<u>22</u>
	<u>chalk & fine sand</u>	<u>22</u>	<u>27</u>
	<u>chalk</u>	<u>27</u>	<u>100</u>
	<u>fine sand + chalk</u>	<u>100</u>	<u>129</u>
	<u>hard core clay sand</u>	<u>129</u>	<u>135</u>
	<u>stagnant water still in sand but getting a little soft chalk</u>		
WELL PURPOSE: <u>home</u> (home, irrigation, municipal, industrial)			

WELL COMPLETION DATA:	
(1) diameter (inches) <u>2"</u>	<u>4' 1 1/4" 2 slot SS with</u>
(2) total depth (feet) <u>135</u>	<u>2' 1 1/4" long pipe bit</u>
(3) static water level (feet) <u>14'</u> ^{below} top of ground.	<u>in well grader</u>
(4) casing <u>steel</u> <u>129'</u> (material) (depth)	<u>42' 1" drive pipe</u>
<u>2'</u> (size) if telescope see back.	CODED
(5) screen <u>4'</u> <u>131'</u> (length) (depth to top)	
<u>1 1/4"</u> (size) <u>2 slot S.S.</u> (material)	
(6) pump <u>1/2</u> <u>8</u> (HP) (yield gpm)	
<u>elec.</u> (type power)	
(7) electric log <u>no</u> (yes or no)	
(organization running log)	
(8) how well bottom plugged <u>metal plug</u>	

DRILLERS REMARKS:

If well telescopes please sketch and show depths.

GROUND LEVEL

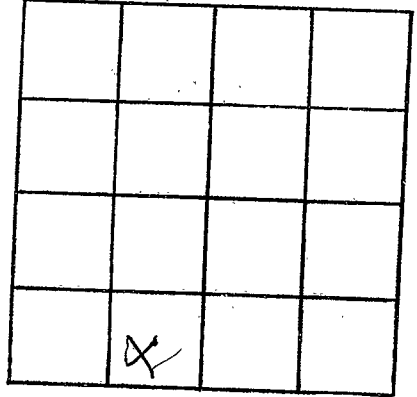

SECTION 26

Please indicate well location X.

ADDITIONAL INFORMATION

If more than one screen,
show locations of each on sketch.