

WAYNE
L 49
11/3/78

MISSISSIPPI
BOARD OF WATER COMMISSIONERS
416 North State Street
Jackson, Mississippi 39201

CODED

WATER WELL DRILLERS LOG

11/3 1978 Griner Drilling Wayne
date well completed firm name county well located

LANDOWNER:	description of formations encountered	from	to
Inexco 1100 Milam Bldg. Ste 1900 Houston, TX 77002 (mailing address)	Topsoil & sand	0	21
WELL LOCATION: sec. 22 T 8 N R 9 E Hwy. 84 - Wayne Co. (distance) (direction) (nearest town)	Chalk	21	105
WELL PURPOSE: oil field supply (home, irrigation, municipal, industrial)	Sand	105	210
WELL COMPLETION DATA: (1) diameter (inches) 4" (2) total depth (feet) 210' (3) static water level (feet) 60' ^{below} _{above} top of ground. (4) casing 4" 168' (material) (depth) 4" If telescope see back. (size) (5) screen 42' 126' perforated (length) (depth to top) 4" (size) (material) (6) pump 80 (HP) (yield gpm) AC (type power) (7) electric log (yes or no) (organization running log) (8) how well bottom plugged orange peel	2000' S + 1500' E of NW Cor of Sec.		
DRILLERS REMARKS:			

CODED


RECEIVED

NOV - 8 1978

MISS. BD. OF WATER COMM

If well telescopes please sketch and show depths.

GROUND LEVEL

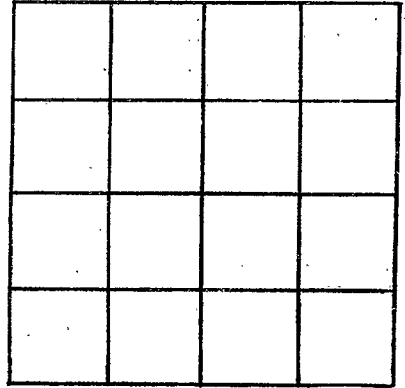

SECTION _____

Please indicate well location X.

ADDITIONAL INFORMATION

If more than one screen,
show locations of each on sketch.