

WAYNE
L 50
10/12/80

MISSISSIPPI
BOARD OF WATER COMMISSIONERS
416 North State Street
Jackson, Mississippi 39201

CODED

WATER WELL DRILLERS LOG

Griner Drilling Service, Inc *Wayne*

10-12-80
date well completed

firm name

county well located

LANDOWNER:
Getty Oil Corporation
P.O. Box 16878
Mobile, Ala. 36616
(mailing address)

description of formations encountered	from	to
<i>clay</i>	<i>0</i>	<i>100</i>
<i>clay & sand</i>	<i>100</i>	<i>253</i>
<i>sand, clay mostly sand</i>	<i>253</i>	<i>315</i>
<i>clay, rock, sand</i>	<i>315</i>	<i>380</i>

CODED

WELL LOCATION: *1200' N + 620' E*
32-8 N R 9 E of
32-13 Waynesboro
30 miles of
(distance) (direction) (nearest town)

no 1
alfred
foote

WELL PURPOSE: *oil field supply*
(home, irrigation, municipal, industrial)

WELL COMPLETION DATA:

- (1) diameter (inches) *4"*
- (2) total depth (feet) *380'*
- (3) static water level (feet) *100'* below top of ground.
- (4) casing *steel 315'*
(material) (depth)
4"
(size) If telescope see back.
- (5) screen *42', 273'*
(length) (depth to top)
4" perforated
(size) (material)
- (6) pump *80*
(HP) (yield gpm)
ac
(type power)
- (7) electric log *—*
(yes or no)

(organization running log)

(8) how well bottom plugged *orange*
seal

DRILLERS REMARKS:


DEPT. OF NATURAL RESOURCES
BUREAU OF LAND & WATER RESOURCES

OCT 23 1980

RECEIVED

If well telescopes please sketch and show depths.

GROUND LEVEL

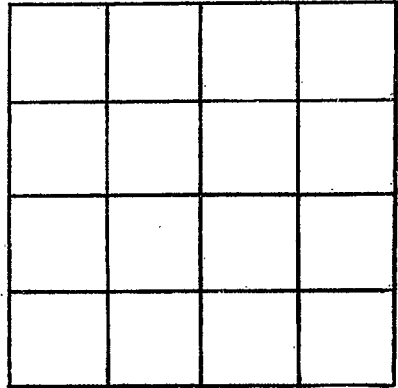

SECTION _____

Please indicate well location X.

ADDITIONAL INFORMATION

If more than one screen,
show locations of each on sketch.