

WAYNE
 L 51
 11/3/80

MISSISSIPPI
 BOARD OF WATER COMMISSIONERS
 416 North State Street
 Jackson, Mississippi 39201

CODED

WATER WELL DRILLERS LOG

Nov. 3 1980 C. P. Clark Water Wells Wayne
 date well completed firm name county well located

LANDOWNER: Trace Drilling Corp., P.O. Box 994 Natchez, Ms.
 (mailing address)

description of formations encountered	from	to
Clay w/ soft sdy sh	0	105
Sand	105	119
Hard clay	119	125
Sand & clay mixed	125	132
Sand	132	173
clay	173	175
Sand	175	200
clay	200	210

WELL LOCATION:
 sec. 21 T 8 N R 9 E
 2 miles N of Strouthing
 (distance) (direction) (nearest town)

WELL PURPOSE: Industrial
 (home, irrigation, municipal, industrial)

- WELL COMPLETION DATA:
- (1) diameter (inches) 4
 - (2) total depth (feet) 208
 - (3) static water level (feet) 3 below top of ground.
 - (4) casing Bl. Steel 175' (material) (depth)
 (size) if telescope see back.
 - (5) screen 25' (length) ~~175'~~ 175' (depth to top)
 2" Stainless Steel (size) (material)
 - (6) pump — 100+ (HP) (yield gpm)
 Air Compressor (type power)
 - (7) electric log no (yes or no)
 (organization running log)
 - (8) how well bottom plugged. BWV

DRILLERS REMARKS:


DEPT. OF NATURAL RESOURCES
 BUREAU OF LAND & WATER RESOURCES

DEC 1 1980

RECEIVED

If well telescopes please sketch and show depths.

GROUND LEVEL

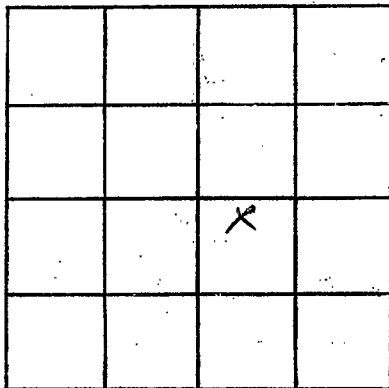

SECTION 21

Please indicate well location X.

ADDITIONAL INFORMATION

If more than one screen, show locations of each on sketch.