

MISSISSIPPI DEPARTMENT OF NATURAL RESOURCES

Bureau of Land and Water Resources


Southport Mall

P.O. Box 10631

Jackson, Mississippi 39209

WATER WELL DRILLERS LOG

Griner Drilling Service, Inc.

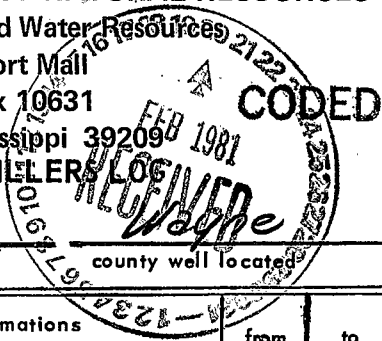

Wayne  
L 52  
2/4/81

date well completed

firm name

county well located

LANDOWNER:

Weaver Oil & Gas  
5599 San Felipe  
Suite 1100

Houston, Texas address 77056

WELL LOCATION:

1650'S + 1650'E  
NO 1 sec 34 T-8 R-9 of  
Fairchild Windham et al  
NW/4

WELL PURPOSE: oil field supply  
(home, irrigation, municipal, industrial)

description of formations encountered

from

to

clay

0 50

sand

50 61

clay

61 100

sand

100 195

streaked - few rocks

195 273

clay

273 315

WELL COMPLETION DATA:

- (1) diameter (inches) 3"
- (2) total depth (feet) 315'
- (3) static water level (feet) flowing w above top of ground.
- (4) casing steel, 189' (material) (depth)
- 3" (size) If telescope see back.
- (5) screen 42', 147' (length) (depth to top)
- 3" perforated (size) (material)
- (6) pump 80 (HP) (yield gpm)
- AC (type power)
- (7) electric log (yes or no)
- (organization running log)

(8) how well bottom plugged Orange  
pell

DRILLERS REMARKS:


DEPT. OF NATURAL RESOURCES  
BUREAU OF LAND & WATER RESOURCES

FEB 20 1981

RECEIVED

If well telescopes please sketch and show depths.

GROUND LEVEL

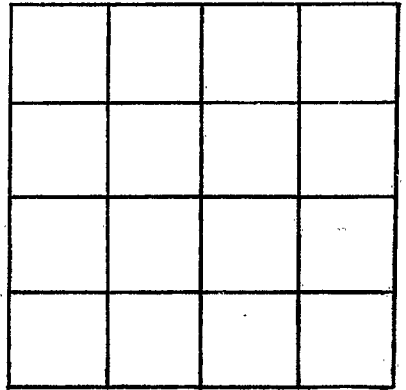

SECTION \_\_\_\_\_

Please indicate well location X.

ADDITIONAL INFORMATION

If more than one screen,  
show locations of each on sketch.