

MISSISSIPPI DEPARTMENT OF NATURAL RESOURCES

Bureau of Land and Water Resources

Southport Mall

P.O. Box 10631

CODED.

Jackson, Mississippi 39209

WATER WELL DRILLERS LOG

Wayne
L 54
6-26-81

date well completed

firm name

county well located

6-26-81 *Griner Drilling Service, Inc.* *Wayne*

LANDOWNER:

Weaver Oil & Gas
5599 San Felipe
Suite 1100

description of formations encountered

from

to

sand, pea gravel 0 231'

Houston, TX 77056

WELL LOCATION: *2310' N + 2310' W*

2310' N + 2310' W

#1 *Monroe* sec. *17-80* R. *9* of *24*

OF SE/Cor of Sec.

(distance) miles *North Waxahatchee Field* (nearest town)


WELL PURPOSE: *oil field supply*
(home, irrigation, municipal, industrial)

WELL COMPLETION DATA:

- (1) diameter (inches) *4"*
- (2) total depth (feet) *231'*
- (3) static water level (feet) *40'* ^{below} top of ground.
- (4) casing *steel*, *231'*
(material) (depth)
4"
(size) If telescope see back.
- (5) screen *42'*, *189'*
(length) (depth to top)
4", *perforated*
(size) (material)
- (6) pump *80*
(HP) (yield gpm)
AC
(type power)
- (7) electric log *—*
(yes or no)
—
(organization running log)

CODED.


(8) how well bottom plugged *range*
peel

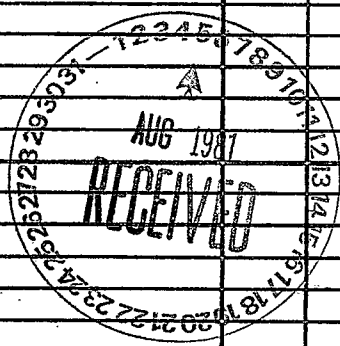

DRILLERS REMARKS:

If well telescopes please sketch and show depths.

GROUND LEVEL

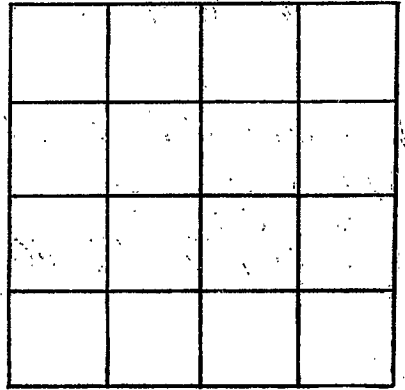

SECTION _____

Please indicate well location X.

ADDITIONAL INFORMATION

If more than one screen,
show locations of each on sketch.