

MISSISSIPPI DEPARTMENT OF NATURAL RESOURCES

Bureau of Land and Water Resources

Southport Mall

P.O. Box 10631

Jackson, Mississippi 39209

WATER WELL DRILLERS LOG

Griner Drilling Service, Inc.

CODED
Wayne

Wayne
L 57
10-28-81

10-28-81
date well completed

Griner Drilling Service, Inc.
firm name

Wayne
county well located

LANDOWNER:	description of formations encountered	from	to
Weaver Oil & Gas 5599 San Felipe Suite 1100 Houston, Texas 77056	clay + sand	0	84
WELL LOCATION: 330' N + 990' W sec. 17 T 8 N R 9 E of No. 2 Shoemaker North Wausau Field (distance) (direction) (nearest town)	sand	84	105
WELL PURPOSE: oil field supply (home, irrigation, municipal, industrial)	clay + sand	105	168
WELL COMPLETION DATA:	sand	168	210
(1) diameter (inches) 4"	sand + clay	210	315
(2) total depth (feet) 315'			
(3) static water level (feet) 30' below top of ground.			
(4) casing PVC 190' (material) (depth) 4" (size) if telescope see back.			
(5) screen 40' 150' (length) (depth to top) 4" perforated PVC screen (size) (material)			
(6) pump AC (HP) 75 (yield gpm)			
(7) electric log (yes or no) (organization running log)			
(8) how well bottom plugged orange peel			
DRILLERS REMARKS:			

CODED


MISSISSIPPI DEPARTMENT OF NATURAL RESOURCES
BUREAU OF LAND & WATER RESOURCES

NOV 3 -

RECEIVED

If well telescopes please sketch and show depths.

GROUND LEVEL

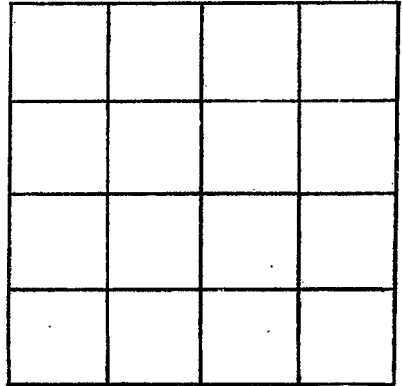

SECTION _____

Please indicate well location X.

ADDITIONAL INFORMATION

If more than one screen,
show locations of each on sketch.