

WAYNE  
L58  
12-3-81

MISSISSIPPI DEPARTMENT OF NATURAL RESOURCES  
Bureau of Land and Water Resources  
Southport Mall  
P.O. Box 10631  
Jackson, Mississippi 39209  
WATER WELL DRILLERS LOG

CODED

12-3-81 Griner Drilling Service, Inc.

Wayne

date well completed

firm name

county well located

LANDOWNER:  
Hughes & Hughes  
114 Capital Towers  
Jackson, Ms.  
(mailing address)

description of formations encountered	from	to
clay, sand	0	150
sand	150	210
clay	210	224
clay	224	231

WELL LOCATION: 150' N + 200' E  
S<sub>55</sub> 21° T 8° N R 9 E SW/4 COR  
Chisler Wausau Field  
1/8 miles (direction) of (nearest town)

WELL PURPOSE: oil field supply  
(home, irrigation, municipal, industrial)

WELL COMPLETION DATA:

- (1) diameter (inches) 3"
- (2) total depth (feet) 231'
- (3) static water level (feet) 40' <sup>below</sup>/<sub>above</sub> top of ground.
- (4) casing steel, 210'  
(material) (depth)  
3"  
(size) if telescope see back.
- (5) screen 42', 168'  
(length) (depth to top)  
3" perforated  
(size) (material)
- (6) pump —, 75  
(HP) (yield gpm)  
AC  
(type power)
- (7) electric log —  
(yes or no)

CODED

(organization running log)

(8) how well bottom plugged per orange

DRILLERS REMARKS:


DEPT. OF NATURAL RESOURCES  
BUREAU OF LAND & WATER RESOURCES

DEC 17 1981

RECEIVED

If well telescopes please  
sketch and show depths.

GROUND LEVEL

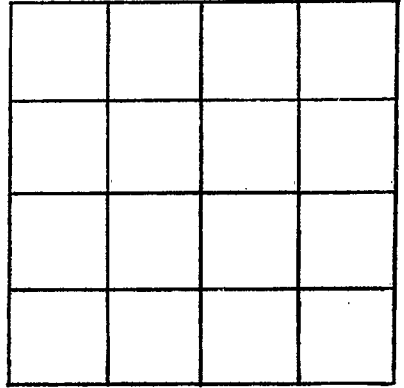

SECTION \_\_\_\_\_

Please indicate well location X.

ADDITIONAL INFORMATION

If more than one screen,  
show locations of each on sketch.