

MISSISSIPPI DEPARTMENT OF NATURAL RESOURCES

Bureau of Land and Water Resources

Southport Mall

P.O. Box 10631

Jackson, Mississippi 39209

WATER WELL DRILLERS LOG

CODED

WAYNE
L59
2-14-82

Griner Drilling Service, Inc.

Wayne

2-14-82 date well completed

Griner Drilling Service, Inc. firm name

Wayne county well located

LANDOWNER:  
 Hughes & Hughes  
 111 Capital Towers  
 Jackson, MS. 39201  
 (mailing address)

description of formations encountered

from

to

chalk  
 SAND

0 189  
 189 231

WELL LOCATION: 920'S + 500'W  
 sec. 28, 8 R 9 E NE/40  
 No. 2 Chismor Wausau Field  
 (distance) miles (direction) of (nearest town)

WELL PURPOSE: oil field supply  
 (home, irrigation, municipal, industrial)

WELL COMPLETION DATA:

- (1) diameter (inches) 3"
- (2) total depth (feet) 231'
- (3) static water level (feet) 20' below top of ground.
- (4) casing steel 231' (material) (depth)  
 3" (size) if telescope see back.
- (5) screen 42', 189' (length) (depth to top)  
 3" perforated (size) (material)
- (6) pump 75 (HP) (yield gpm)  
 AC (type power)
- (7) electric log (yes or no)  
 (organization running log)
- (8) how well bottom plugged orange  
 peel

CODED

DEPT. OF NATURAL RESOURCES  
 BUREAU OF LAND & WATER RESOURCES


FEB 18 1982

RECEIVED

DRILLERS REMARKS:

If well telescopes please  
sketch and show depths.

GROUND LEVEL

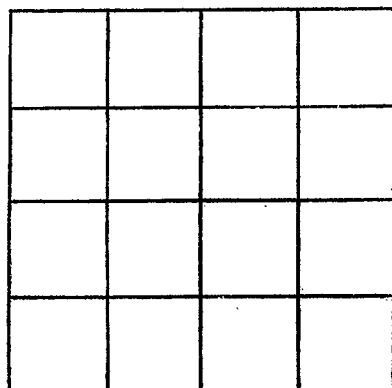

SECTION \_\_\_\_\_

Please indicate well location X.

ADDITIONAL INFORMATION

If more than one screen,  
show locations of each on sketch.