

MISSISSIPPI DEPARTMENT OF NATURAL RESOURCES

Bureau of Land and Water Resources

Southport Mall

P.O. Box 10631

Jackson, Mississippi 39209

WATER WELL DRILLERS LOG

Griner Drilling Service, Inc.

Wayne

L62

WAYNE CO.

10-27-83

10-27-83

date well completed

firm name

county well located

LANDOWNER:

See Land Drilling
P.O. Box 311
Magnolia, MS 39652
(mailing address)

description of formations encountered

from

to

sand, clay 0 21

chalk 21 147

SAND 147 210

WELL LOCATION: 2310' N + 550' W

No. 3 c. 21 T-8 N R-9 E SE/40
Chosmor Wausau Field
2 1/4 miles (distance) of (direction) (nearest town)

WELL PURPOSE: oil field supply
(home, irrigation, municipal, industrial)

WELL COMPLETION DATA:

- (1) diameter (inches) 3"
- (2) total depth (feet) 210'
- (3) static water level (feet) 20' below top of ground.
- (4) casing steel 210' (material) (depth)
3" (size) if telescope see back.
- (5) screen 42' 268' (length) (depth to top)
3" perforated (size) (material)
- (6) pump - 70 (HP) (yield gpm)
AC (type power)
- (7) electric log - (yes or no)
(organization running log)
- (8) how well bottom plugged orange peel


DRILLERS REMARKS:

DEPT. OF NATURAL RESOURCES
BUREAU OF LAND & WATER RESOURCES

NOV 29 1983
RECEIVED

If well telescopes please sketch and show depths.

GROUND LEVEL.

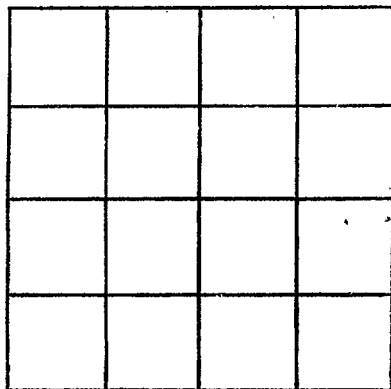

SECTION _____

Please indicate well location X.

ADDITIONAL INFORMATION

If more than one screen,
show locations of each on sketch.