

MISSISSIPPI DEPARTMENT OF NATURAL RESOURCES
Bureau of Land and Water Resources
 Southport Mall
 P.O. Box 10631
 Jackson, Mississippi 39209

CODED

WATER WELL DRILLERS LOG

L-63
Wayne
1-24-85

Griner Drilling Service, INC.

Wayne

1-24-85
 date well completed

Griner Drilling Service, INC.
 firm name

Wayne
 county well located


LANDOWNER:	description of formations encountered	from	to
Mosbacher Production 1300 Main Street Suite 2100 Houston, Texas 77002 <small>(mailing address)</small>	clay	0	168
WELL LOCATION: 600 W 1200 E sec. 21 T 8 N R 9 E of No. 1 Gmd. Wausau Field Land Co. miles (distance) (direction) (nearest town)	sand	168	180
WELL PURPOSE: oilfield supply <small>(home, irrigation, municipal, industrial)</small>	clay	180	189
WELL COMPLETION DATA:	sand	189	210
(1) diameter (inches) <u>4"</u>	clay	210	357
(2) total depth (feet) <u>357'</u>			
(3) static water level (feet) <u>10'</u> <small>(below above top of ground)</small>			
(4) casing <u>Steel, 210'</u> <small>(material) (depth)</small> <u>4"</u> <small>(size) if telescope see back.</small>			
(5) screen <u>42', 168'</u> <small>(length) (depth to top)</small> <u>4" perforated</u> <small>(size) (material)</small>			
(6) pump <u>—</u> <u>75-85</u> <small>(HP) (yield gpm)</small> <u>AC</u> <small>(type power)</small>			
(7) electric log <u>—</u> <small>(yes or no)</small> <u>—</u> <small>(organization running log)</small>			
(8) how well bottom plugged <u>orange peel</u>			
DRILLERS REMARKS: <u>—</u>			

RECEIVED
 FEB 11 1985

Department of Natural Resources
 Bureau of Land & Water Resources

If well telescopes please sketch and show depths.

GROUND LEVEL

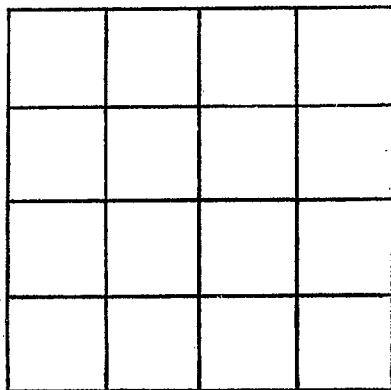

SECTION _____

Please indicate well location X.

ADDITIONAL INFORMATION

If more than one screen, show locations of each on sketch.