

MISSISSIPPI DEPARTMENT OF NATURAL RESOURCES

Bureau of Land and Water Resources

Southport Mall

P.O. Box 10631

Jackson, Mississippi 39209

WATER WELL DRILLERS LOG

L 64
Wayne

4-10-1985 date well completed Roy V. West Drilling firm name Wayne county well located

LANDOWNER: Steve Hodge
LAUREL MS (mailing address)

description of formations encountered	from	to
SAND	0	18
CLAY	18	86
SAND	86	138

WELL LOCATION: sec 31 T 8 N R 9 E S W
15 miles SE of LAUREL (distance) (direction) (nearest town)

WELL PURPOSE: Chicken House (home, irrigation, municipal, industrial)

- WELL COMPLETION DATA:
- (1) diameter (inches) 4"
 - (2) total depth (feet) 148'
 - (3) static water level (feet) 52' below top of ground.
 - (4) casing PVC, 138' (material) (depth)
(size) if telescope see back.
 - (5) screen 10', 138' (length) (depth to top)
4" PVC (size) (material)
 - (6) pump 1 (HP), 27 (yield gpm)
REA (type power)
 - (7) electric log NO (yes or no)
(organization running log)
 - (8) how well bottom plugged WASH VALVE


RECEIVED
MAY 2 1985

DRILLERS REMARKS:

Department of Natural Resources
Bureau of Land & Water Resources

If well telescopes please sketch and show depths.

GROUND LEVEL

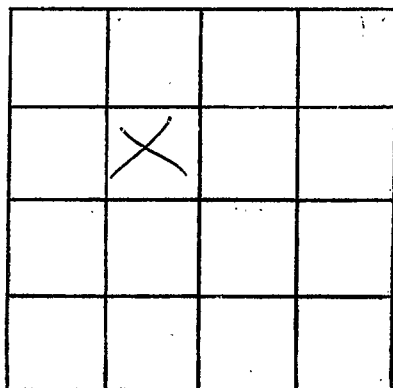

SECTION 31

Please indicate well location X.

ADDITIONAL INFORMATION

If more than one screen,
show locations of each on sketch.