

Wayne
L 65
6-9-85

MISSISSIPPI
BOARD OF WATER COMMISSIONERS
416 North State Street
Jackson, Mississippi 39201

CODED
CODED

WATER WELL DRILLERS LOG

Griner Drilling
Service, Inc.

Wayne

date well completed

firm name

county well located

LANDOWNER:

Exeter Drilling
144 Elk Place
Suite 1502

description of formations encountered

from to

chalk 0 60

sand 60 64

chalk 64 189

fine sand 189 231

chalk 231 252

sand 252 270

chalk 270 289

sand 289 357

chalk 357 360

New Orleans, La. 70112

WELL LOCATION: 2150' S 4215314

SONAT. Co. 31 T 8 N R 9 E of
No. 1-31 Thompson Oil Field
Georgia Pacific (distance) (direction) (nearest town)

WELL PURPOSE: oilfield supply
(home, irrigation, municipal, industrial)

WELL COMPLETION DATA:

(1) diameter (inches) 3"

(2) total depth (feet) 360'

(3) static water level (feet) 80' below top of ground.

(4) casing steel 357' (material) (depth)

3" (size) if telescope see back.

(5) screen 42' 315' (length) (depth to top)

3" perforated (size) (material)

(6) pump AC 75 (HP) (yield gpm)

AC (type power)

(7) electric log (yes or no)

(organization running log)

(8) how well bottom plugged orange peel


DRILLERS REMARKS:

RECEIVED
JUL 11 1985

Department of Natural Resources
Bureau of Land & Water Resources

If well telescopes please sketch and show depths.

GROUND LEVEL

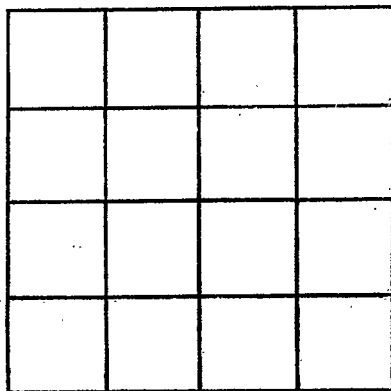

SECTION _____

Please indicate well location X.

ADDITIONAL INFORMATION

If more than one screen, show locations of each on sketch.