

L 67
 WAYNE
 8-30-85

MISSISSIPPI
 BOARD OF WATER COMMISSIONERS
 416 North State Street
 Jackson, Mississippi 39201

CODED

WATER WELL DRILLERS LOG

Griner Drilling
 Service, Inc.

Wayne

8-30-85
 date well completed

Griner Drilling Service, Inc.
 firm name

Wayne
 county well located

LANDOWNER:

Mosbacher Production
 1300 Main Street
 Suite 200
 Houston, Texas 77002
 (mailing address)

description of formations encountered

from to

chalk 0 10

SAND CODED 10 15

chalk 15 84

streaked 84 126

sand 126 231

chalk 231 235

WELL LOCATION: 500'S + 1600'E

No. 1 sec. 28 T. 8 N. R. 9 E. of
 wheelers Wausau Field
 et al 28-3 miles (distance) of (direction) (nearest town)

WELL PURPOSE: OTHER SUPPLY
 (home, irrigation, municipal, industrial)

WELL COMPLETION DATA:

- (1) diameter (inches) 4"
- (2) total depth (feet) 235'
- (3) static water level (feet) 30' below top of ground.
- (4) casing steel 231' (material) (depth)
 4" (size) if telescope see back.
- (5) screen 42' 189' (length) (depth to top)
 4" perforated (size) (material)
- (6) pump (HP) 80 (yield gpm)
 AC (type power)
- (7) electric log (yes or no) (no)

(organization running log)

(8) how well bottom plugged orange peel


DRILLERS' REMARKS:

RECEIVED
 SEP 23 1985

Department of Natural Resources
 Bureau of Land & Water Resources

If well telescopes please sketch and show depths.

GROUND LEVEL

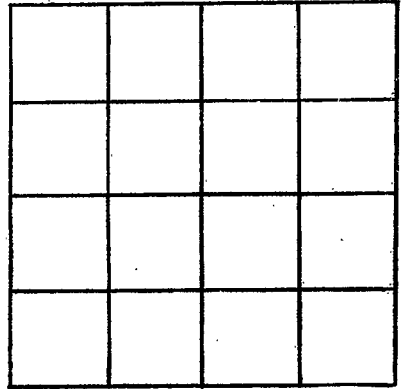

SECTION _____

Please indicate well location X.

ADDITIONAL INFORMATION

If more than one screen,
show locations of each on sketch.