

MISSISSIPPI DEPARTMENT OF ENVIRONMENTAL QUALITY
Bureau of Land and Water Resources

P. O. Box 10631
Jackson, MS 39289-0631
WATER WELL DRILLERS LOG

COUNTY WELL LOCATED
Wayne

WELL NUMBER 268 CODED ✓

DATE WELL COMPLETED
2/2/92

PERMIT NUMBER
0-402

NAME OF DRILLING FIRM
Tom Griffith

Water Well Inc.

274 e

NAME & MAILING ADDRESS OF LANDOWNER
Energy Drilling Co.
P.O. Box 905
Natchez, MS 39120

WELL LOCATION: SEC 218 TOWNSHIP 8 S RANGE 9 E

DISTANCE 9 Miles E DIRECTION of Laurel NEAREST TOWN

OTHER LANDMARK

WELL PURPOSE: Home, Irrigation, Municipal, Industrial, Fish Pond, etc.
rig supply

PUMP DATA

PUMP TYPE (Circle One):
Submersible, Turbine, Jet, Flowing Well,
Other (Describe) AIR

POWER TYPE (Circle One):
Electric, Tractor, Diesel, Gasoline, Butane,
Other (Describe) _____ H/P _____

Pump Capacity (GPM) 150 No. of Stages _____ Setting Depth 160 FT.

PUMP TEST
Well yielded 150 GPM with
a drawdown of _____ ft.
after _____ hours of pumping

WELL DATA

Well Depth <u>240'</u>	Casing Diameter (In.) <u>4"</u>	Casing Length (Ft.) <u>210'</u>
Type of Casing <u>PVC</u>	Hole Depth <u>240'</u>	Depth to Static Water Level <u>5'</u>

TYPE OF COMPLETION: (Circle One or More):
Gravel Packed, Underreamed, Telescoped,
Natural Development, Open Hole, Other

Top of Lap Pipe or Reduction in Casing

FEET IF TELESCOPED OR MORE THAN ONE SCREEN: USE BACK PAGE

LOG DATA

TYPE OF LOG RUN (Circle One): No Log Run,
Electric, Gamma Ray, Density, Sonic, Neutron,
Other (Describe) _____

Name of Organization Running Log

SCREEN DATA

Diameter - Inches <u>3"</u>	Length - Feet <u>30'</u>	Slot Size - Inches <u>.013</u>
Screen Type <u>PVC Slot</u>	Depth to Bottom - Feet <u>240'</u>	

GEOLOGIC DATA (Office Use Only)

Surface Elev.	Geologic Unit	Unit Thickness	Depth to Top
Subs. SWL	Date	Analysis	Aquifer Test


Driller's Remarks
338' N E 791' W OF SE/ COR.

DESCRIPTION OF FORMATIONS ENCOUNTERED	FROM	TO	FORMATIONS (Continued)	FROM	TO
<u>pipe clay</u>	<u>1</u>	<u>60</u>	RECEIVED <u>APR 20 1992</u> Dept. of Environmental Quality Bureau of Land & Water Resources		
<u>sand</u>	<u>60</u>	<u>90</u>			
<u>clay</u>	<u>90</u>	<u>120</u>			
<u>sand</u>	<u>120</u>	<u>160</u>			
<u>clay</u>	<u>160</u>	<u>190</u>			
<u>sand</u>	<u>190</u>	<u>240</u>			

IF MORE SPACE IS NEEDED, USE BACK

If well telescopes please
sketch and show depths.

GROUND LEVEL

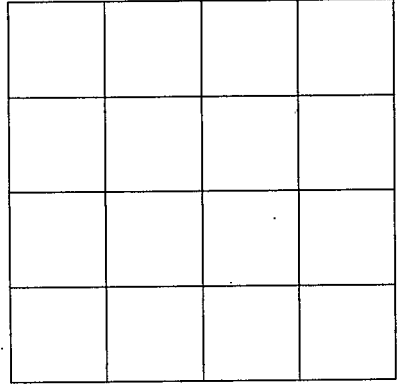

SECTION _____

Please indicate well location X.

ADDITIONAL INFORMATION

If more than one screen,
show location of each on sketch.