

STATE WELL REPORT

Part 1

Driller's Log

Mississippi Department of Environmental Quality
Office of Land and Water Resources
P.O. Box 2309
Jackson, MS 39225-2309
(601)961-5555
(601)961-5228 (fax)

For Office Use Only:

Well #: L112
Aquifer: _____
E-Log #: _____

County: Wayne

Permit #: _____

Driller: A.J. Fincher

Date drilling completed: ~~5-15-18~~
6-1-18

State Law requires that this report be prepared by the license holder responsible for the work and filed with the Department at the above address within 30 days of completion of drilling of the well or borehole.

Well Owner Information <small>(Landowner if borehole is not for a water well)</small>	Well or Borehole Location
Owner Name: <u>Scott Smith</u>	Latitude: <u>31.68306</u> Longitude: <u>88.86472</u> <u>31.40588 N</u>
Mailing Address: <u>12 Jim West Dr</u>	Method of Lat/Long (check one): Conventional Survey _____, USGS quad _____, Hand-held GPS <input checked="" type="checkbox"/> , Survey-grade GPS _____
<u>Waynesboro MS 39367</u> City State Zip Code	<u>SW 1/4 SE 1/4, Sec 2 T 8 N R 9 W</u>
Telephone No. (601) <u>325-2452</u>	<u>2</u> Miles <u>W</u> of <u>Wistler</u> (Distance) (Direction) (Nearest Town)

Well / Borehole Data
Date drilling started: <u>5-15-18</u> Date drilling completed: <u>6-1-18</u> Hole depth: <u>250</u> Hole diameter: <u>6"</u>
Location of the source of any surface water used for drilling: <u>Public Supply</u>
Method of dosing and volume of Chlorine used in drilling and development: _____
Logs run (check all applicable): <input type="checkbox"/> log run <input checked="" type="checkbox"/> Electric <input checked="" type="checkbox"/> Gamma Ray <input type="checkbox"/> Density <input type="checkbox"/> Sonic <input type="checkbox"/> Neutron Other: _____
Name of organization running log(s): <u>M.D.E.Q.</u>
Purpose of borehole (check one): Water Well <input checked="" type="checkbox"/> Geotechnical/Geological Investigation <input type="checkbox"/> Ground Source Heat Pump <input type="checkbox"/> Seismic Survey Other (describe) _____
<i>If drilling is not related to water well construction, skip the remainder of this block</i>
Purpose of Well (check all applicable): <input type="checkbox"/> Home <input type="checkbox"/> Industrial <input type="checkbox"/> Public Supply <input type="checkbox"/> Irrigation <input type="checkbox"/> Fish Culture Other (describe): <u>Poultry</u>
If a flowing well, method of flow regulation: Valve _____ Other (describe) _____
Static Water Level: <u>48'</u> feet <input type="checkbox"/> above or <input type="checkbox"/> below land surface Date measured: <u>6-1-18</u> (check one)
Method of measurement (check one) <input type="checkbox"/> Steel tape <input type="checkbox"/> Electric tape <input type="checkbox"/> Air line <input type="checkbox"/> Other (describe): _____
Well depth: <u>167'</u> Well grouted to a depth of: <u>50</u> feet Type of grout (check one) <input type="checkbox"/> Neat Cement <input type="checkbox"/> Bentonite <input checked="" type="checkbox"/> Mix
Casing length: <u>140</u> feet Casing diameter: <u>4</u> inches Type of casing: <u>PVC</u>
Screen length: <u>20</u> feet Screen diameter: <u>4</u> inches Type of screen: <u>PVC</u>
Screen slot size: <u>1006</u> inches Setting depth: From <u>140</u> feet to <u>160</u> feet
Type of completion (check all applicable) <input type="checkbox"/> gravel packed <input type="checkbox"/> Underreamed <input type="checkbox"/> Open hole <input checked="" type="checkbox"/> Natural Development
Other (describe): _____
Top of lap pipe or reduction in casing: _____ feet
<i>If telescoped or more than one screen, describe on next page</i>

RECEIVED
 SEP 04 2018
 BY OLWR

County: Wayne


Permit #: _____

For Office Use Only:

Well #: L112

The sketch below only required for water wells


If well telescopes, show depths on sketch.

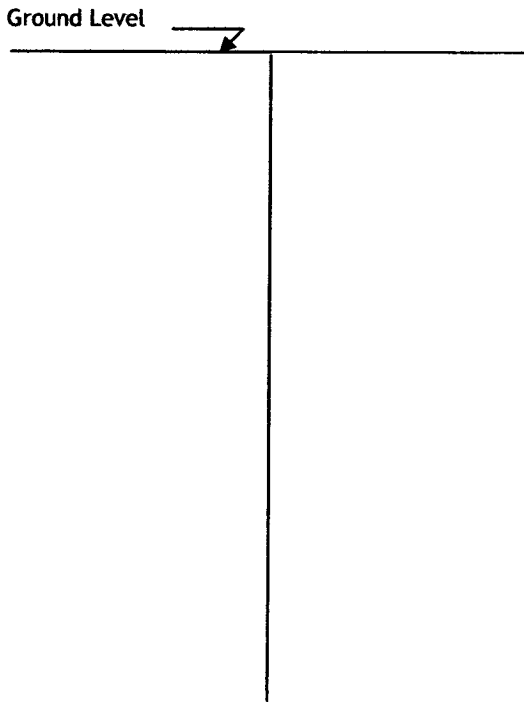

Description of formations encountered must be provided for all wells and boreholes, unless specifically exempted by regulations

Description of Formations Encountered	From (depth)	To (depth)
Sand & clay	Ground level	20
Clay	20	31
Rock	31	32
Gray clay	32	50
sandy clay	50	75
Hard clay	75	100
clay + sand streaks	100	110
Sand	110	200
Gray clay	200	225
Shud	225	250'

If more than one screen, show location of each on sketch

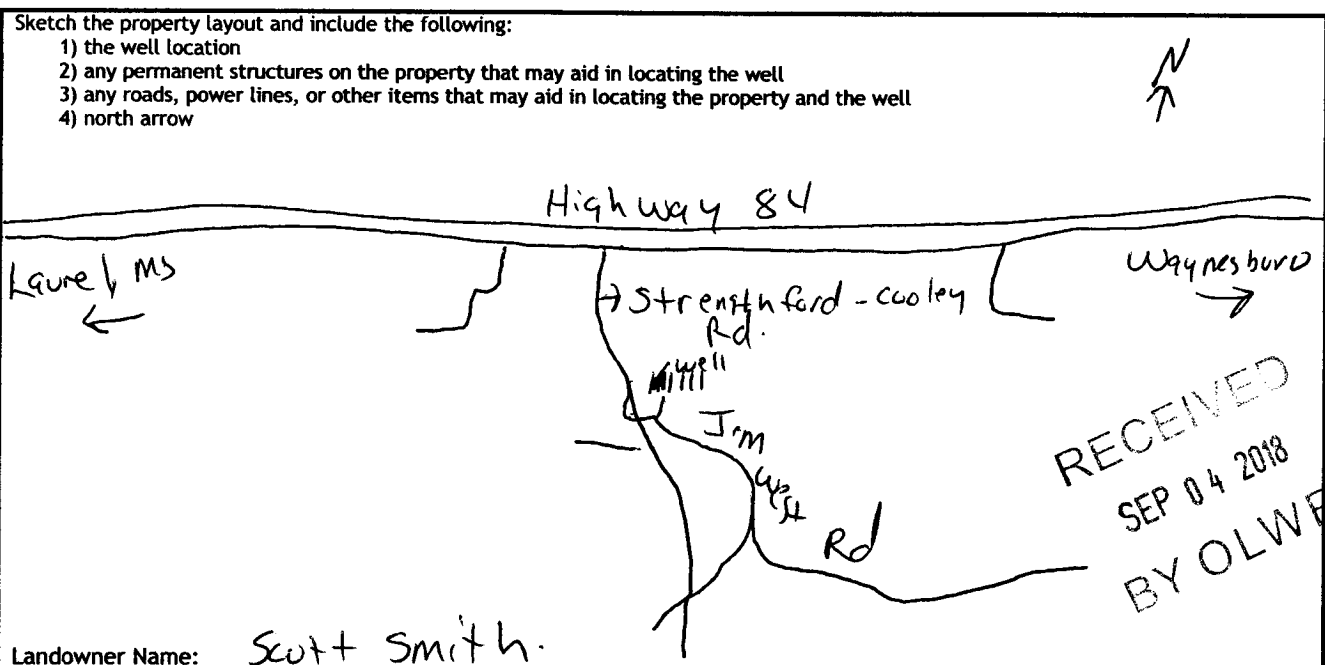

I HEREBY CERTIFY that the well/borehole was drilled, constructed, and completed in accordance with all applicable requirements of the Mississippi Department of Environmental Quality and the Mississippi Department of Health regulations, if applicable, and state laws.

Arnold Fincher Jr 0-560 7-1-18 [Signature]

Print Name of Responsible Licensee and License No. Date Signature of Licensee

STATE WELL REPORT

Part 2

Pump Installer's Completion Report
Mississippi Department of Environmental Quality
Office of Land and Water Resources
P.O. Box 2309
Jackson, MS 39225-2309
(601)961-5210
(601) 360-0535 (fax)

County: Wayne
Permit #: _____
Driller: Will Barlow
Date completed: 6-18-18
Copy information from block on Part 1

For Office Use Only:
Well #: L112
Aquifer: _____

This part of the report must be completed by a licensed water well contractor or a licensed pump installer. A copy of Part 1 of the report must be attached and both parts filed with the Department at the above address within 30 days of well completion.

Well Owner Information	Well Location
Owner Name: <u>Scott Smith</u>	Latitude: <u>31.40588^N</u> Longitude: <u>88.51534^W</u>
Mailing Address: <u>12 Jim West Dr</u>	Method of Lat/Long (check one): Conventional Survey _____, USGS quad _____, Hand-held GPS <input checked="" type="checkbox"/> , Survey-grade GPS _____
<u>Waynesboro MS 39367</u> City State Zip Code	<u>SW ¼ SE ¼, Sec 2 T 8 N R 9 W</u>
Telephone No. <u>(601) 325-2452</u>	<u>2</u> Miles <u>W</u> of <u>Wistler</u> (Distance) (Direction) (Nearest Town)

Pump Type (check one)

Submersible Turbine Air Lift Centrifugal Flowing Well Jet Piston Rotary Other (describe): _____

Date Pump Installed: 6-18-18 Rated Pump Capacity: 60 Gallons Per Minute

Is This Pump (check one): New Repaired Replacement

Power Type (check one)

Electric Diesel Gasoline Natural Gas Tractor PTO Windmill Other (describe): _____

Horse Power Rating of Motor: 3 Setting Depth: 120 feet Number of Stages: 7

Pump Test Data for Non Flowing Well

Date Well Tested: 6-18-18 Duration of Pump Test (minimum 4 hours): 4 hours

Static Water Level (A): 48' Feet Below Land Surface Pumping Water Level (B): 70' Feet Below Land Surface

Drawdown [(B) - (A)]: 22 Feet Below Land Surface Test Pumping Rate: 60 Gallons Per Minute

Method of measurement (check one): Steel tape Electric tape Air line Other (describe): _____

Pump Test Data for Flowing Well

Measured shut in head: _____ feet.

Well yielded _____ GPM with a drawdown of _____ feet after _____ hours of pumping

Meter Installation

Meter Manufacturer: _____ Meter Serial Number: _____

Meter Model Number/Name: _____ Type of Meter: _____

Totalizer Register Unit and Multiplier Factor (AF x .001, gal x 1000, etc): _____

Installation Date: _____ Meter installed by: _____

Is This Meter (check one): New Repaired Replacement

Important: By submitting the above information you are certifying that this meter was installed to manufacturer standards. For agricultural wells, a list of approved meters is on the MDEQ website.

RECEIVED
SEP 04 2018
BY OLWR

I HEREBY CERTIFY that the above statements are true to the best of my knowledge.

Arnold Fincher Jr 0-560 7-1-18
Print Name of Pump Installer and License No. (if applicable) Date Signature of Pump Installer