

**MISSISSIPPI
BOARD OF WATER COMMISSIONERS**
416 North State Street
Jackson, Mississippi 39201

WAYNE
L 2000
12-11-75

13¢

WATER WELL DRILLERS LOG

Dec 11 1975 Reynolds Waterwells Wayne
date well completed firm name county well located

LANDOWNER: <u>Jame Meeks</u> <u>RT 6</u> <u>Lauriel</u> (mailing address)	description of formations encountered	from	to
		0	5
	clay	5	30
	sandy clay	30	60
	clay	60	89
	sand		

WELL LOCATION:
sec. 8 T. 8 N. R. 9 E
1 1/4 miles S of Lauriel
(distance) (direction) (nearest town)

WELL PURPOSE: Home
(home, irrigation, municipal, industrial)


- WELL COMPLETION DATA:**
- (1) diameter (inches) 2
 - (2) total depth (feet) 89
 - (3) static water level (feet) 40 below above top of ground.
 - (4) casing galv 84
(material) (depth)
(size) If telescope see back.
 - (5) screen 5
(length) (depth to top)
1/4 St Steel
(size) (material)
 - (6) pump 1/2 4
(HP) (yield gpm)
REA
(type power)
 - (7) electric log no
(yes or no)
(organization running log)
 - (8) how well bottom plugged washed

DRILLERS REMARKS:

JAN 6 1976
MISS. BD. OF WATER COMMISSIONERS

If well telescopes please sketch and show depths.

GROUND LEVEL

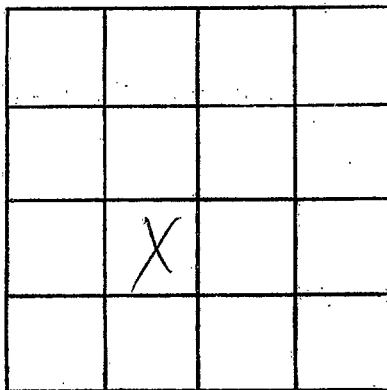

SECTION 8

Please indicate well location X.

ADDITIONAL INFORMATION

If more than one screen, show locations of each on sketch.