

WAYNE
 L 2001
 5-21-76

MISSISSIPPI
 BOARD OF WATER COMMISSIONERS
 416 North State Street
 136 Jackson, Mississippi 39201

WATER WELL DRILLERS LOG

May 21, 1976
 date well completed

McILWAIN WATER WELL SERVICE Wayne
 RT. 2 BOX 37
 WAYNESBORO, MISS. 39367
 county well located

LANDOWNER:
 Mr. Leroy Taylor
 Waynesboro, Miss.
 (mailing address)

description of formations encountered	from	to
Red Clay	0	10
" Sand	10	19

WELL LOCATION:
 sec. 14 T. 8 N R. 9 E
 13 miles W of Waynesboro
 (distance) (direction) (nearest town)

Clay	19	31
Sand	31	33

WELL PURPOSE: Home
 (home, irrigation, municipal, industrial)

Clay	33	46
------	----	----

WELL COMPLETION DATA:
 (1) diameter (inches) 2"
 (2) total depth (feet) 84'
 (3) static water level (feet) 44 below top of ground.
 (4) casing PVC 80' (material) (depth)
 2" (size) if telescope see back.
 (5) screen 4' 80' (length) (depth to top)
 2" PVC (size) (material)
 (6) pump 1 12 (HP) (yield gpm)
 220 AC (type power)
 (7) electric log No (yes or no)
 (organization running log)
 (8) how well bottom plugged


Fine Sand	46	51
Clay	51	65
Sand	65	68
Clay	68	69
Sand	69	72
Clay	72	74
Sand	74	84

DRILLERS REMARKS:

JUN 1 1976

If well telescopes please sketch and show depths.

GROUND LEVEL

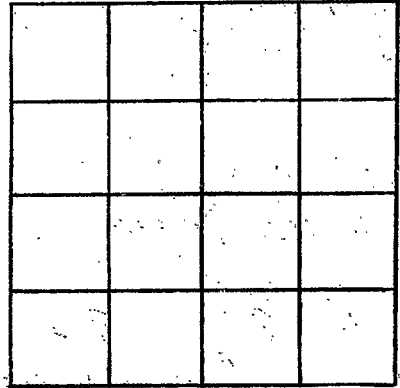

SECTION _____

Please indicate well location X.

ADDITIONAL INFORMATION

If more than one screen, show locations of each on sketch.