

Wayne
L. 25002
9/28/76

MISSISSIPPI
BOARD OF WATER COMMISSIONERS
416 North State Street
Jackson, Mississippi 39201

WATER WELL DRILLERS LOG

Sept 28 1976 Porter Drilling & Exp. Wayne
date well completed firm name county well located

LANDOWNER: Verlone
Brattonville
At 5 Hargreaves, Miss.
(mailing address)

description of formations encountered	from	to
	clay & sand	0
clay	18	32
clay & sand	32	44
clay	44	92
fine & soft sand	92	110
clay	110	140
med & sand	140	148
stop on clay		

WELL LOCATION:
sec 35 T 2 N R 9 E
S W
1 miles east of Brattonville
(distance) (direction) (nearest town)

WELL PURPOSE: None
(home, irrigation, municipal, industrial)

WELL COMPLETION DATA:

(1) diameter (inches) 2"

(2) total depth (feet) 148'

(3) static water level (feet) 10 (below/above top of ground)

(4) casing P.V.C. 144'
(material) (depth)
2" If telescope see back.
(size)

(5) screen 4' 144'
(length) (depth to top)
2" 7 slot SS
(size) (material)

(6) pump none set
(HP) (yield gpm)

(type power)

(7) electric log (yes or no)

(organization running log)

(8) how well bottom plugged 1 1/4" backwash valve

4' 2" 7 slot SS. with
1 1/4" backwash valve
on end of steel pipe
above


DRILLERS REMARKS:

RECEIVED
NOV - 3 1976

MISS. BD. OF WATER COMMISSIONERS

If well telescopes please sketch and show depths.

GROUND LEVEL

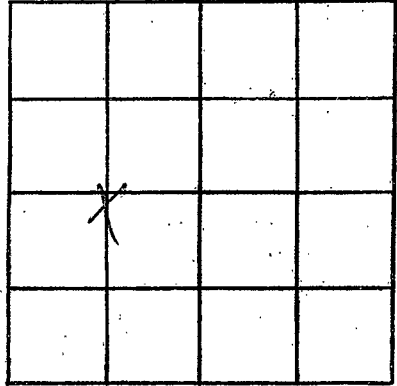

SECTION 35

Please indicate well location X.

ADDITIONAL INFORMATION

If more than one screen, show locations of each on sketch.