

C. P. CLARK
WATER WELL DRILLING

MISSISSIPPI
 BOARD OF WATER COMMISSIONERS
 416 North State Street
 Jackson, Mississippi 39201

WATER WELL DRILLERS LOG

Wayne
L 2003
10/19/76

13¢

10/19 1976 C.P. Clark Wayne
 date well completed firm name county well located

LANDOWNER: Bob Sumner
Rt 4 Laurel, Miss.

description of formations encountered	from	to
Sandy Clay	0	5
Clay	5	21
Clay Sand streaks	21	36
Clay	36	117
Fine Sand streaks	117	124
Fine Sand (Solid)	124	142
Clay	142	160
Sandy Clay	160	174
Sand	174	201

(mailing address)

WELL LOCATION:

sec. 20 T 8 N R 9 E
3 miles NW of Sturgis
 (distance) (direction) (nearest town)

WELL PURPOSE: Home
 (home, irrigation, municipal, industrial)

WELL COMPLETION DATA:

- (1) diameter (inches) 2
- (2) total depth (feet) 201
- (3) static water level (feet) 28 below top of ground.

(4) casing Galvneal 196
 (material) (depth)

(size) If telescope see back.

(5) screen 5 196
 (length) (depth to top)
1/4 Solids S, 006
 (size) (material)

(6) pump P 200 lpm with air
 (HP) (yield gpm)

(type power)

(7) electric log _____
 (yes or no)

(organization running log)

(8) how well bottom plugged BWU


DRILLERS REMARKS: Customer to furnish install own pump

RECEIVED
 NOV - 8 1976

MISS. Bd. OF WATER COMMISSIONERS

If well telescopes please sketch and show depths.

GROUND LEVEL

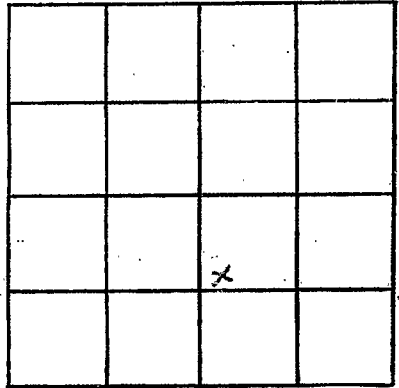

SECTION 211

Please indicate well location X.

ADDITIONAL INFORMATION

If more than one screen, show locations of each on sketch.