

WAYNE  
L 2004  
5/1/77

MISSISSIPPI  
BOARD OF WATER COMMISSIONERS  
416 North State Street  
13¢ Jackson, Mississippi 39201

WATER WELL DRILLERS LOG

May 77 date well completed  
J. Olsen Water also Drill firm name  
Wayne county well located

LANDOWNER:  
Jack West  
R#4 Laurel miss.  
(mailing address)

WELL LOCATION:  
sec. 31 T 8 N R 9 E  
10 miles SE Laurel  
(distance) (direction) of (nearest town)

WELL PURPOSE:  
(home, irrigation, municipal, industrial)

WELL COMPLETION DATA:

(1) diameter (inches) 4

(2) total depth (feet) 160

(3) static water level (feet) 62 below top of ground.

(4) casing PVC 155  
(material) (depth)  
if telescope see back.

(5) screen 5' 155  
(length) (depth to top)  
2x008 PVC  
(size) (material)

(6) pump 1 6  
(HP) (yield gpm)  
110  
(type power)

(7) electric log no  
(yes or no)

(organization running log)

(8) how well bottom plugged

description of formations encountered		from	to
Red Clay		0	5
white chalk		5	10
" "	" "	10	20
" "	" "	20	30
" "	" "	30	35
fine sand		35	40
" "	" "	40	45
white chalk		45	50
" "	" "	50	60
yellow chalk		60	70
blue "		70	80
" "	" "	80	90
" "	" "	90	100
" "	" "	100	110
" "	" "	110	115
fine sand		115	120
" "	" "	120	130
" "	" "	130	140
" "	" "	140	150
" "	" "	150	160


RECEIVED  
JUL 25 1977

MISS. Bd. OF WATER COMMISSIONERS

DRILLERS REMARKS:

If well telescopes please sketch and show depths.

GROUND LEVEL

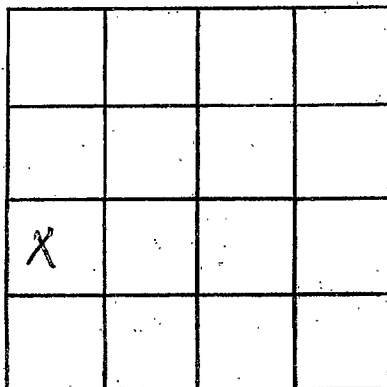

SECTION 31

Please indicate well location X.

ADDITIONAL INFORMATION

If more than one screen, show locations of each on sketch.