

Wayne
L 2000
8/11/77

MISSISSIPPI
BOARD OF WATER COMMISSIONERS
416 North State Street
Jackson, Mississippi 39201

WATER WELL DRILLERS LOG

8-11-77
date well completed

J. R. GREEN - WATER WELL DRILLING WAYNE
RTE 6, BOX firm name NONE 425-3237 county well located
LAUREL, MISS 39440

LANDOWNER:
Arnold Overstreet
R. 1 Box 392 Laurel
(mailing address) 39440

WELL LOCATION:
sec. 5 T 8 N R 9 E
S W
10 miles S of Laurel
(distance) (direction) (nearest town)

WELL PURPOSE:
(home, irrigation, municipal, industrial)

WELL COMPLETION DATA:

(1) diameter (inches) 4

(2) total depth (feet) 130

(3) static water level (feet) 39 below
top of ground. above

(4) casing PVC 110
(material) (depth)

(size) if telescope see back.

(5) screen 15' 110
(length) (depth to top)

2x.008 PVC
(size) (material)

(6) pump 1 12
(HP) (yield gpm)

220VAC
(type power)

(7) electric log NO
(yes or no)

(organization running log)

(8) how well bottom plugged

description of fomations encountered	from	to
yellow clay	0	10
" "	10	12
SAND	12	18
yellow	18	20
" "	20	30
Blue chalk	30	40
" "	40	50
" "	50	58
" SAND	58	60
white chalk	60	66
" SAND	66	70
" CHALK	70	80
" "	80	90
" "	90	94
FINE SAND	94	100
" "	100	110
" "	110	120
" "	120	125
white chalk	125	130


RECEIVED
JAN 17 1978

MISS. BD. OF WATER COMMISSIONERS
JAN 17 1978

DRILLERS REMARKS:

If well telescopes please sketch and show depths.

GROUND LEVEL

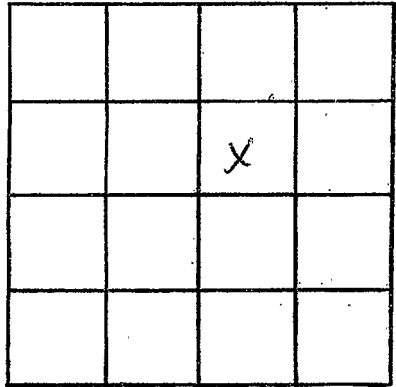

NW-NE

SECTION 5

Please indicate well location X.

ADDITIONAL INFORMATION

If more than one screen, show locations of each on sketch.