

WAYNE

L 2007

6-08-78

MISSISSIPPI BOARD OF WATER COMMISSIONERS 416 North State Street Jackson, Mississippi 39201

WATER WELL DRILLERS LOG

Wayne

6-8-78

Greenwater wellbldg

Jones

date well completed

firm name

county well located

LANDOWNER:

Jacobson
R H Laurie

(mailing address)

WELL LOCATION:

sec. 30 T 8 N R 9 E
10 miles E LAUREL of (nearest town)

WELL PURPOSE:

(home, irrigation, municipal, industrial)

WELL COMPLETION DATA:

- (1) diameter (inches) 4
- (2) total depth (feet) 193
- (3) static water level (feet) 75 below top of ground.
- (4) casing PVC 180 (material) (depth)
- (5) screen 10 (size) 180 (length) (depth to top) 2" x 008 (size) PVC (material)
- (6) pump 1 (HP) 6 (yield gpm)
- (7) electric log no (yes or no)
- (8) how well bottom plugged

description of formations encountered

from to

Red Clay	0	10
White Sand	10	30
" Chalk	30	30
FINE SAND	34	40
White Chalk	40	50
" "	50	60
" "	60	70
FINE SAND	70	75
White Chalk	75	80
" "	80	90
" "	90	100
" "	100	110
" "	110	115
FINE SAND	115	120
" "	120	130
Yellow Clay	130	135
FINE SAND	135	140
" "	140	150
Blue Chalk	150	160
" "	160	170
Rock + White Sand	170	180
" " "	180	190
" " "	190	193
Blue Clay	193	


RECEIVED
DEC 28 1978

DRILLERS REMARKS:

MISS. BD. OF WATER COMM

If well telescopes please sketch and show depths.

GROUND LEVEL

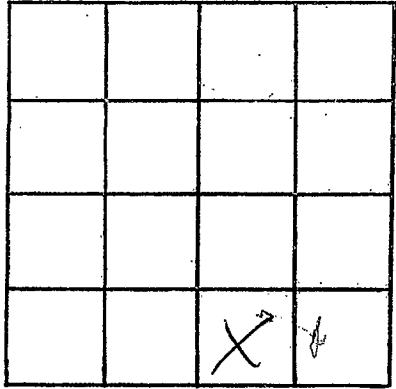

SECTION 30

Please indicate well location X.

ADDITIONAL INFORMATION

If more than one screen,
show locations of each on sketch.