

Wayne
L 2008
1-4-80

MISSISSIPPI
BOARD OF WATER COMMISSIONERS
416 North State Street
Jackson, Mississippi 39201

WATER WELL DRILLERS LOG

1-4-80 1980 Roy V. West Drilling WAYNE
date well completed firm name county well located

LANDOWNER: Noel McKee	description of formations encountered	from to	
(mailing address)			
	CLAY	0'	30'
	SILTY CLAY	30'	50'
	CLAY	50'	155'
	SAND	155'	165'

WELL LOCATION:
sec. 8 T 8 N R 9 E
S W
18 miles E of LAUREL
(distance) (direction) (nearest town)

WELL PURPOSE: HOME
(home, irrigation, municipal, industrial)

- WELL COMPLETION DATA:
- (1) diameter (inches) 2"
 - (2) total depth (feet) 165'
 - (3) static water level (feet) 12' below above top of ground.
 - (4) casing PVC, 160'
(material) (depth)
(size) if telescope see back.
 - (5) screen 5', 160'
(length) (depth to top)
1 1/2", STAINLESS STEEL
(size) (material)
 - (6) pump 1, 10
(HP) (yield gpm)
Electric
(type power)
 - (7) electric log NO
(yes or no)
 - (organization running log)
 - (8) how well bottom plugged WASH VALVE

DRILLERS REMARKS:


DEPT. OF NATURAL RESOURCES
BUREAU OF LAND & WATER RESOURCES

JAN 25 1980

RECEIVED

If well telescopes please sketch and show depths.

GROUND LEVEL

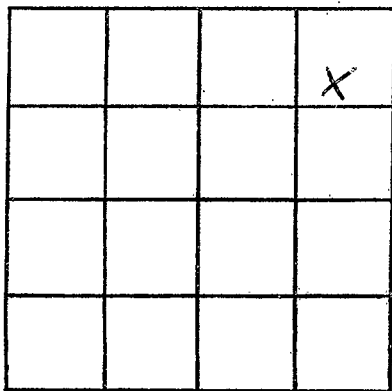

SECTION 8

Please indicate well location X.

ADDITIONAL INFORMATION

If more than one screen, show locations of each on sketch.