

Wayne
 L 200
 9-25-80

MISSISSIPPI
 BOARD OF WATER COMMISSIONERS
 416 North State Street
 Jackson, Mississippi 39201

WATER WELL DRILLERS LOG

Sept 25 1980 Roy V. West Drilling Wayne
 date well completed firm name county well located

LANDOWNER:
 Anderson Kelly
 (mailing address)

description of formations encountered	from	to
CLAY	0	18
SAND	18	24
CLAY	24	102
CLAY SAND	102	122

WELL LOCATION:
 sec. 35 T 8 N R 9 E
 S W
 1.5 miles E of LAUREL
 (distance) (direction) (nearest town)

WELL PURPOSE: HOME
 (home, irrigation, municipal, industrial)

WELL COMPLETION DATA:

(1) diameter (inches) 2"

(2) total depth (feet) 122'

(3) static water level (feet) 59' below top of ground.

(4) casing PVC 117' (material) (depth)

(size) if telescope see back.

(5) screen 5' 117' (length) (depth to top)

2" PVC (size) (material)

(6) pump 1 10 (HP) (yield gpm)

REA (type power)

(7) electric log NO (yes or no)

(organization running log)

(8) how well bottom plugged ORSA VALVE

DEPT. OF NATURAL RESOURCES
 BUREAU OF LAND & WATER RESOURCES


OCT 17 1980

RECEIVED

DRILLERS REMARKS:

If well telescopes please sketch and show depths.

GROUND LEVEL

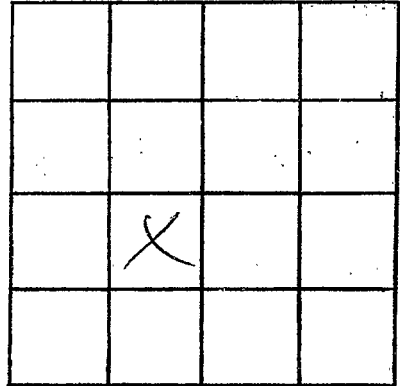

SECTION 35

Please indicate well location X.

ADDITIONAL INFORMATION

If more than one screen,
show locations of each on sketch.