

MISSISSIPPI DEPARTMENT OF NATURAL RESOURCES

Bureau of Land and Water Resources

Southport Mall

P.O. Box 10631

Jackson, Mississippi 39209

WATER WELL DRILLERS LOG

WAYNE
L 2001
1/22/81

Jan 22 1981 date well completed
Bohrer Drilling & Log firm name
Itasca county well located

LANDOWNER: Louis McLean
At 1 Itascaboro, Miss

| description of formations encountered | from | to |
|---------------------------------------|------|-----|
| clay | 0 | 52 |
| rock | 52 | 53 |
| clay | 53 | 80 |
| fine sand | 80 | 84 |
| clay | 84 | 169 |
| red sand | 169 | 172 |
| clay | 172 | 190 |
| red fine sand & clay | 190 | 195 |
| fine sand | 195 | 223 |

(mailing address)

WELL LOCATION:
sec 23 T 8 N R 9 E
2 miles N Itascaboro (distance) (direction) (nearest town)

WELL PURPOSE: home (home, irrigation, municipal, industrial)

WELL COMPLETION DATA:

- (1) diameter (inches) 2"
- (2) total depth (feet) 223
- (3) static water level (feet) 45 below top of ground
- (4) casing PVC 218' (material) (depth)
2' (size) if telescope see back.
- (5) screen 5' 218' (length) (depth to top)
2" 6 shot S.S. (size) (material)
- (6) pump 1 (HP) (yield gpm)
elec (type power)
- (7) electric log no (yes or no)
- (organization running log)
- (8) how well bottom plugged 2' rock wash valve

62' 1" P.V.C. drop pipe

DRILLERS REMARKS:


DEPT. OF NATURAL RESOURCES
BUREAU OF LAND & WATER RESOURCES

MAR 6 1981

RECEIVED

If well telescopes please sketch and show depths.

GROUND LEVEL

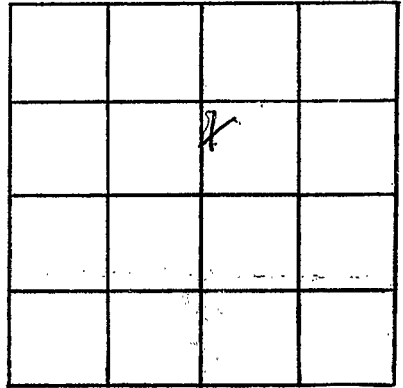

SECTION 23

Please indicate well location X.

ADDITIONAL INFORMATION

If more than one screen,
show locations of each on sketch.