

WAYNE
L 2012
2/20/81

MISSISSIPPI
BOARD OF WATER COMMISSIONERS
416 North State Street
Jackson, Mississippi 39201

WATER WELL DRILLERS LOG

Feb 20 1981 ROY V. WEST DRIG WAYNE
date well completed firm name county well located

LANDOWNER:	description of formations encountered	from	to
<u>Arthur Cooley</u>	<u>CLAY</u>	<u>0</u>	<u>12</u>
	<u>SAND</u>	<u>12</u>	<u>28</u>
(mailing address)	<u>CLAY</u>	<u>28</u>	<u>30</u>
	<u>SAND</u>	<u>30</u>	<u>43</u>

WELL LOCATION:
sec. 16 T. 8 N. R. 9 E
15 miles W of Waynesboro
(distance) (direction) (nearest town)

WELL PURPOSE: HOME
(home, irrigation, municipal, industrial)

- WELL COMPLETION DATA:
- (1) diameter (inches) 2"
 - (2) total depth (feet) 43'
 - (3) static water level (feet) 15' below top of ground
 - (4) casing PVC, 38'
(material) (depth)
(size) if telescope see back.
 - (5) screen 5', 38'
(length) (depth to top)
1/4, stainless steel
(size) (material)
 - (6) pump 1, 12
(HP) (yield gpm)
REA
(type power)
 - (7) electric log NO
(yes or no)
 - (8) how well bottom plugged W/SH VALVE

DRILLERS REMARKS:


DEPT. OF NATURAL RESOURCES
BUREAU OF LAND & WATER RESOURCES

MAY 19 1981

RECEIVED

If well telescopes please sketch and show depths.

GROUND LEVEL

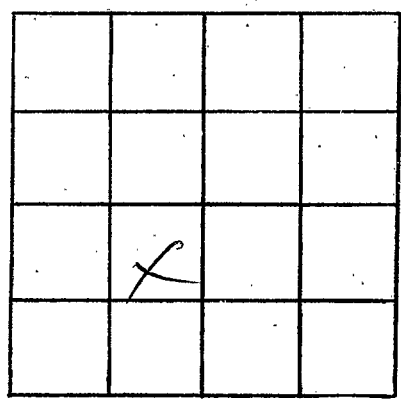

SECTION 16

Please indicate well location X.

ADDITIONAL INFORMATION

Lined area for additional information.

If more than one screen, show locations of each on sketch.