

Wayne
L 2003

MISSISSIPPI
BOARD OF WATER COMMISSIONERS
416 North State Street
Jackson, Mississippi 39201

WATER WELL DRILLERS LOG

Jan 20 1982 Roy W. West Dalg. Wayne
date well completed firm name county well located

LANDOWNER: EVERETT WILLIAMS
description of formations encountered: SANDY CLAY SANDS
from 0 to 6
to 6 52
(mailing address)

WELL LOCATION:
sec 18 T 8 N R 9 E
15 miles E of LAUREL
(distance) (direction) (nearest town)

WELL PURPOSE:
(home, irrigation, municipal, industrial)

WELL COMPLETION DATA:
(1) diameter (inches) 2"
(2) total depth (feet) 53'
(3) static water level (feet) 31' below top of ground.
(4) casing PVC, 48' (material) (depth)
(size) If telescope see back.
(5) screen 5' 48' (length) (depth to top)
1 1/2" STAINLESS STEEL (size) (material)
(6) pump 1/2 HP, 6 (yield gpm)
REA (type power)
(7) electric log NO (yes or no)
(organization running log)
(8) how well bottom plugged W P 3/4 VALVE

DRILLERS REMARKS:


DEPT. OF NATURAL RESOURCES
BUREAU OF LAND & WATER RESOURCES

FEB 10 1982

RECEIVED

If well telescopes please sketch and show depths.

GROUND LEVEL

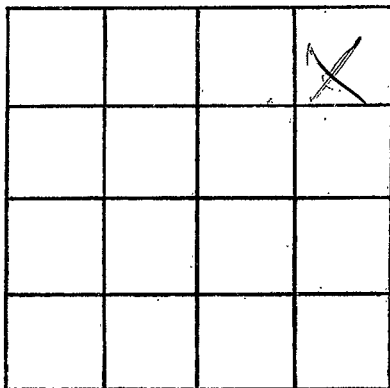

SECTION 18

Please indicate well location X.

ADDITIONAL INFORMATION

If more than one screen, show locations of each on sketch.