

Wayne
L
2014

MISSISSIPPI
 BOARD OF WATER COMMISSIONERS
 416 North State Street
 Jackson, Mississippi 39201

WATER WELL DRILLERS LOG

March 1 1982 Roy W. West Drilling Inc Wayne
 date well completed firm name county well located

LANDOWNER:
Mitchell Hendry
Rt 1 Waynesboro
 (mailing address)

description of formations encountered	from	to
CLAY	0	42
HARD SAND	42	60
CLAY SAND STRKS	60	85
SAND	85	139

WELL LOCATION:
 sec. 2 T. 8 N. R. 9 E
10 miles W of Waynesboro
 (distance) (direction) (nearest town)

WELL PURPOSE: HOME
 (home, irrigation, municipal, industrial)

- WELL COMPLETION DATA:
- (1) diameter (inches) 4"
 - (2) total depth (feet) 139'
 - (3) static water level (feet) 28' below above top of ground.
 - (4) casing PVC, 129'
 (material) (depth)
 (size) if telescope see back.
 - (5) screen 10', 129'
 (length) (depth to top)
4" PVC
 (size) (material)
 - (6) pump 3/4, 28
 (HP) (yield gpm)
REA
 (type power)
 - (7) electric log NO
 (yes or no)
 (organization running log)
 - (8) how well bottom plugged Open end


DRILLERS REMARKS:

DEPT. OF NATURAL RESOURCES
 BUREAU OF LAND & WATER RESOURCES

MAR - 8 1982
 RECEIVED

If well telescopes please sketch and show depths.

GROUND LEVEL

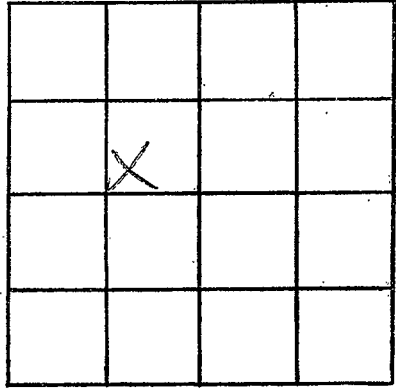

SECTION 2

Please indicate well location X.

ADDITIONAL INFORMATION

A series of horizontal lines for writing additional information, consisting of approximately 20 lines.

If more than one screen, show locations of each on sketch.

