

Wayne
L
2015

MISSISSIPPI
 BOARD OF WATER COMMISSIONERS
 416 North State Street
 Jackson, Mississippi 39201

WATER WELL DRILLERS LOG

Feb 25 1982 Roy V. West Drilling Inc. Wayne
 date well completed firm name county well located


LANDOWNER:	description of formations encountered	from	to
<u>Claude Shoemaker Jr.</u> <u>Rt 1 Box 391 LAUREL</u> (mailing address)			
	<u>SAND</u>	<u>32</u>	<u>79</u>
WELL LOCATION:			
sec. <u>5</u> T <u>8</u> N R <u>9</u> E <small>S W</small>			
<u>10</u> miles <u>E</u> of <u>LAUREL</u> <small>(distance) (direction) (nearest town)</small>			
WELL PURPOSE: <u>Chicken House</u> <small>(home, irrigation, municipal, industrial)</small>			
WELL COMPLETION DATA:			
(1) diameter (inches) <u>4"</u>			
(2) total depth (feet) <u>79'</u>			
(3) static water level (feet) <u>42'</u> below above <small>top of ground.</small>			
(4) casing <u>PVC</u> , <u>69'</u> <small>(material) (depth)</small>			
<small>(size) If telescope see back.</small>			
(5) screen <u>10"</u> , <u>69'</u> <small>(length) (depth to top)</small>			
<u>2"</u> , <u>PVC</u> <small>(size) (material)</small>			
(6) pump <u>1</u> , <u>10</u> <small>(HP) (yield gpm)</small>			
<u>REA</u> <small>(type power)</small>			
(7) electric log <u>no</u> <small>(yes or no)</small>			
<u>WASH VALVE</u> <small>(organization running log)</small>			
(8) how well bottom plugged <u>WASH VALVE</u>			
DRILLERS REMARKS:			

DEPT. OF NATURAL RESOURCES
 BUREAU OF LAND & WATER RESOURCES

MAR - 8 1982
 RECEIVED

If well telescopes please sketch and show depths.

GROUND LEVEL

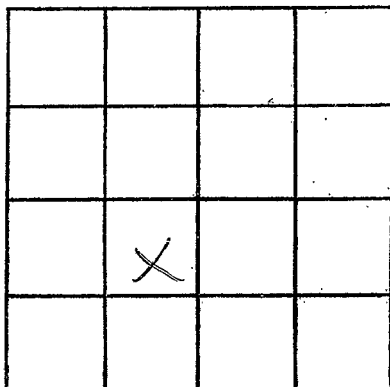

SECTION 5

Please indicate well location X.

ADDITIONAL INFORMATION

If more than one screen, show locations of each on sketch.